


T.4S.R.3E.W.M.

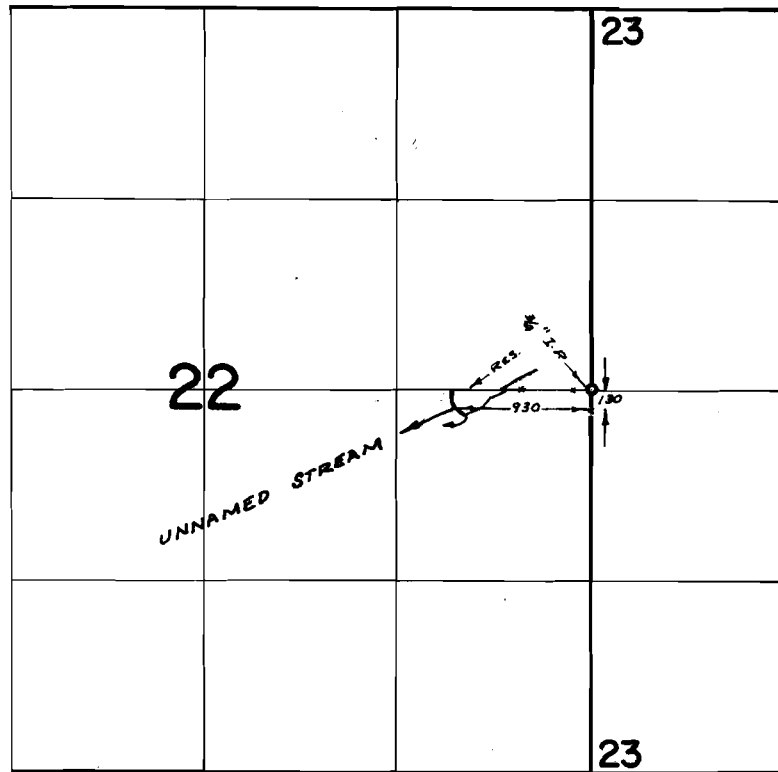

FINAL PROOF SURVEY
UNDER

Application No. ^{R-38682} ~~38683~~ Permit No. ^{R-3285} ~~28781~~
IN NAME OF

..... IRVING MURISON

Surveyed MAY 21, 1971., by R. MUCKEN.