


T.4S.R.3E.W.M.

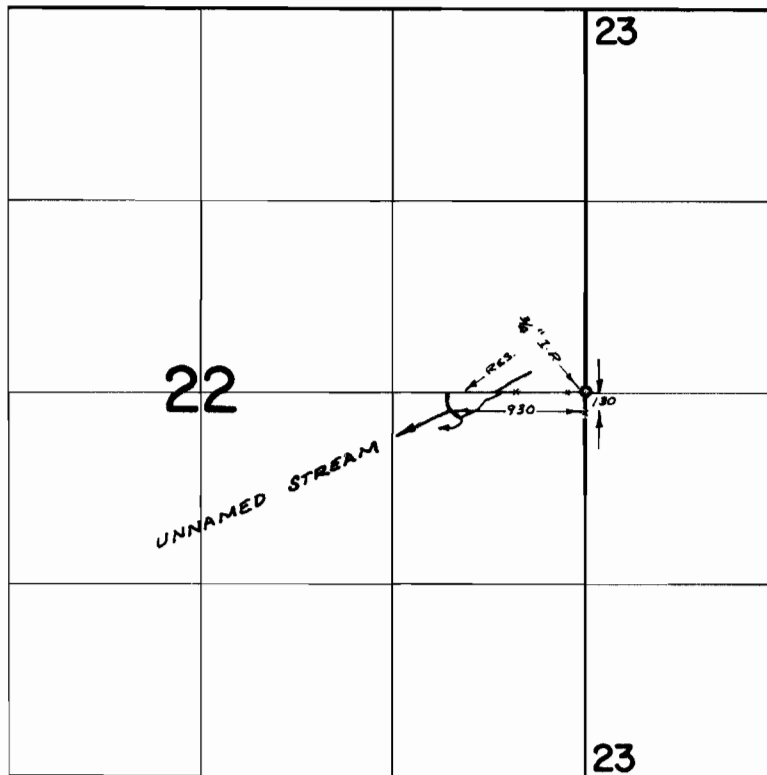

FINAL PROOF SURVEY
UNDER

Application No. *R-38682* ~~38682~~ Permit No. *R-3255* ~~28721~~
IN NAME OF

IRVING MURISON

Surveyed *MAY 21,* 19*71,* by *R. MUCKEN.*