


T. 4 S. R. 2 E. W. M.

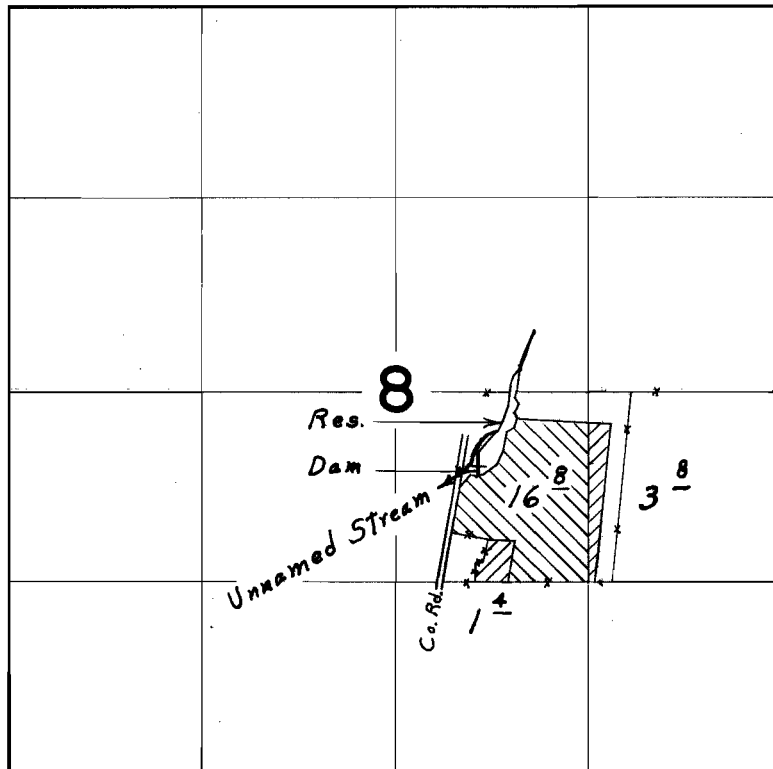

Div. Pt. located 2100' N. & 2080' W. from S.E. Cor. Sec. 8

Primary



Supplemental



FINAL PROOF SURVEY
UNDER

R-39733 R-3973
Application No. 39734 Permit No. 29630
IN NAME OF

WILLIAM S. CARLISLE

Surveyed Sept. 23, 1970, by L. E. Gould