


T. 5 N. R. 7 W. W.M.

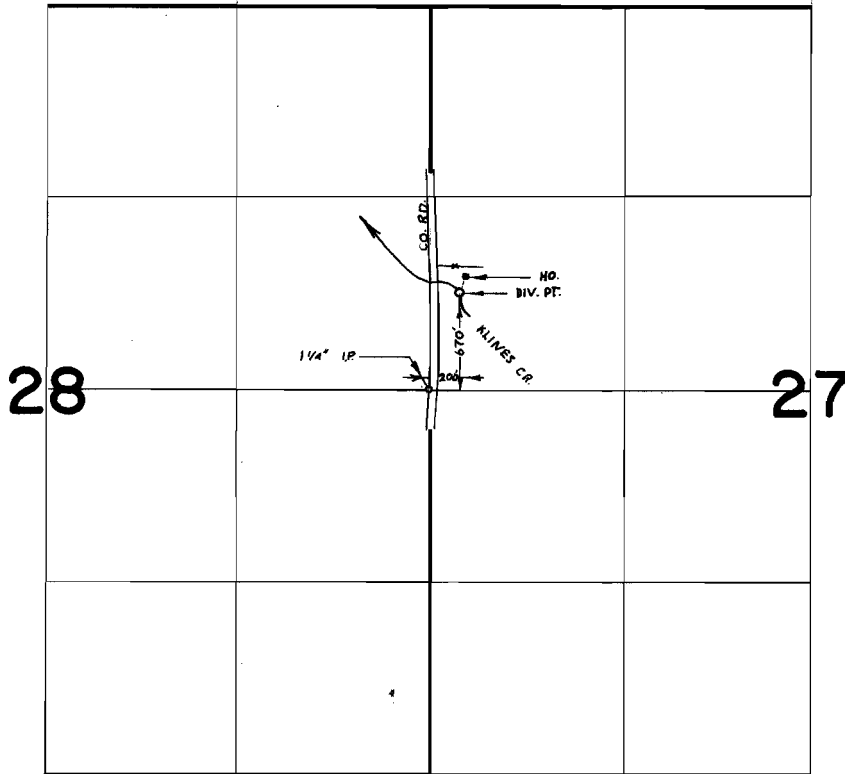

FINAL PROOF SURVEY UNDER

Application No. 43954 Permit No. 32839
IN NAME OF

DENNIS E. & JOAN OLSTEDT

Surveyed JUNE 11, 1971, by R. MUCKEN