


T. 9 N. R. 7 W. W. M.

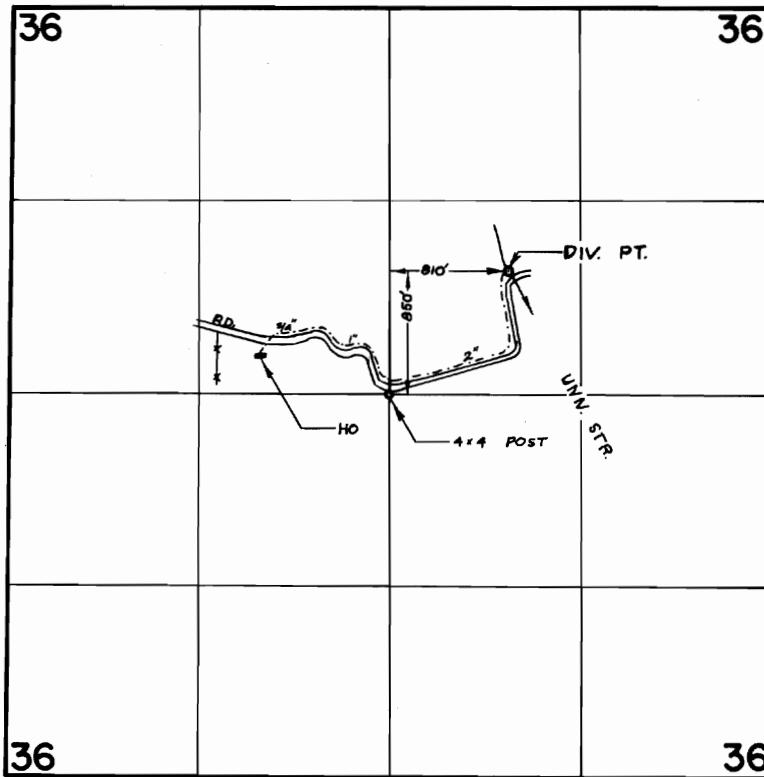

FINAL PROOF SURVEY UNDER

Application No. 44382... Permit No. 33152.....
IN NAME OF

CURTIS J. ALLEN & WALTER A. PALMROSE

Surveyed JUNE 9, 1971, by R. MUCKEN.....