


T.19 S.R.24 E.W.M.

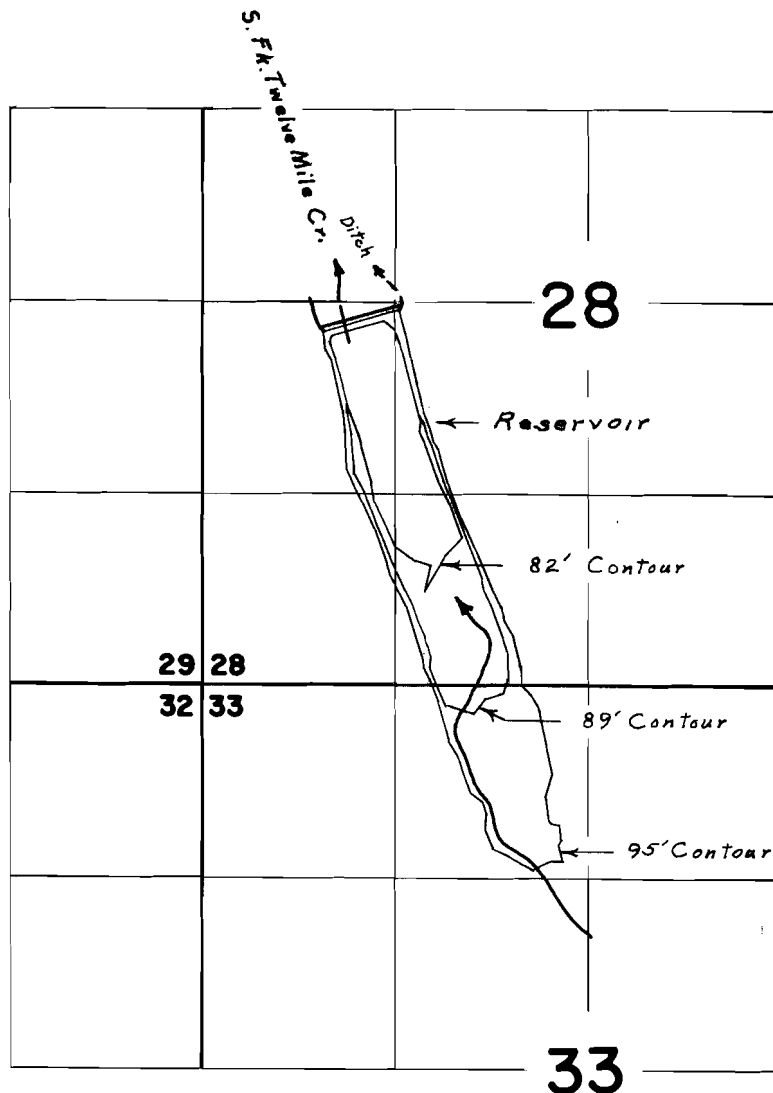

Div Pt. located 130' S. & 43 1/2' W. from E. 1/4 Corner Sec. 28
Note: location of dam made from application map.

FINAL PROOF SURVEY
UNDER

Application No. R-22233 Permit No. R-870
IN NAME OF

BOSTON RANCH COMPANY

Surveyed Oct. 30, 1968, by L. E. Gould