


R.23 E.W.M.

R.24 E.W.M.

T.19S.

T.20S.

CROOK COUNTY
HARNEY COUNTY

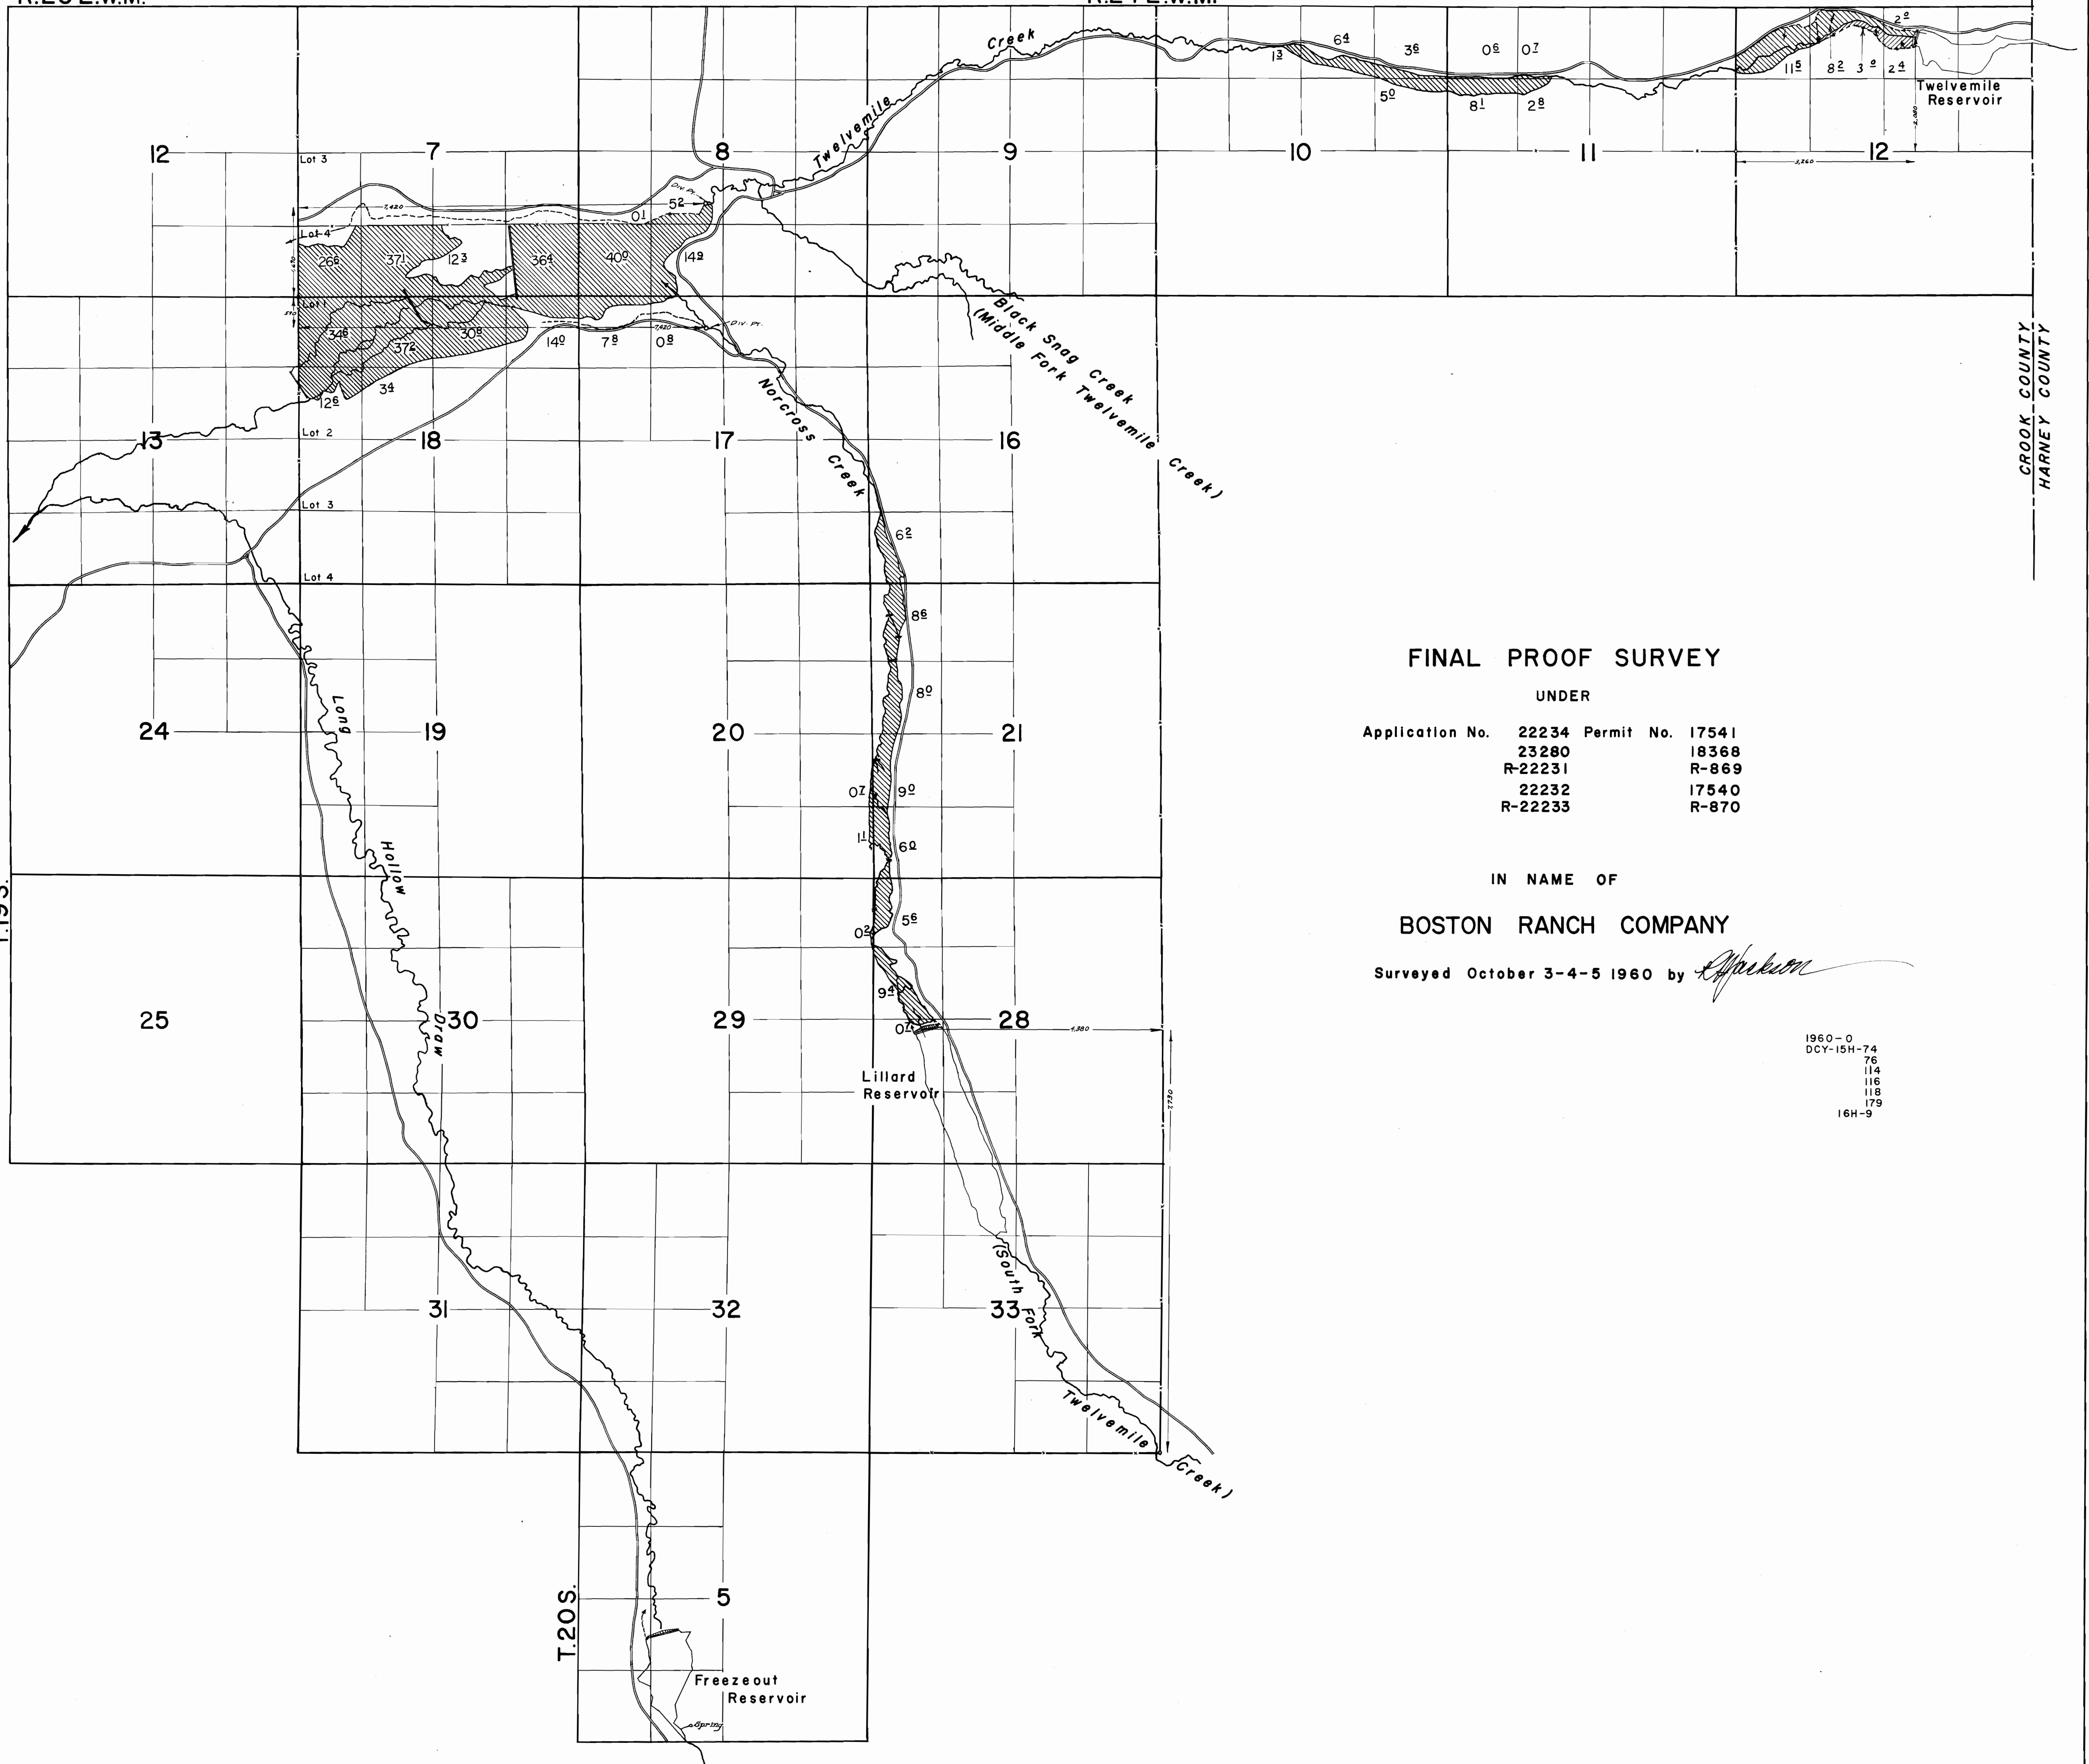

FINAL PROOF SURVEY

UNDER

Application No. 22234 Permit No. 17541
23280 18368
R-22231 R-869
22232 17540
R-22233 R-870

IN NAME OF

BOSTON RANCH COMPANY

Surveyed October 3-4-5 1960 by *A. Jackson*

1960-0
DCY-15H-74
76
114
116
118
179
16H-9