


T 26 S. R 4 W. W. M.

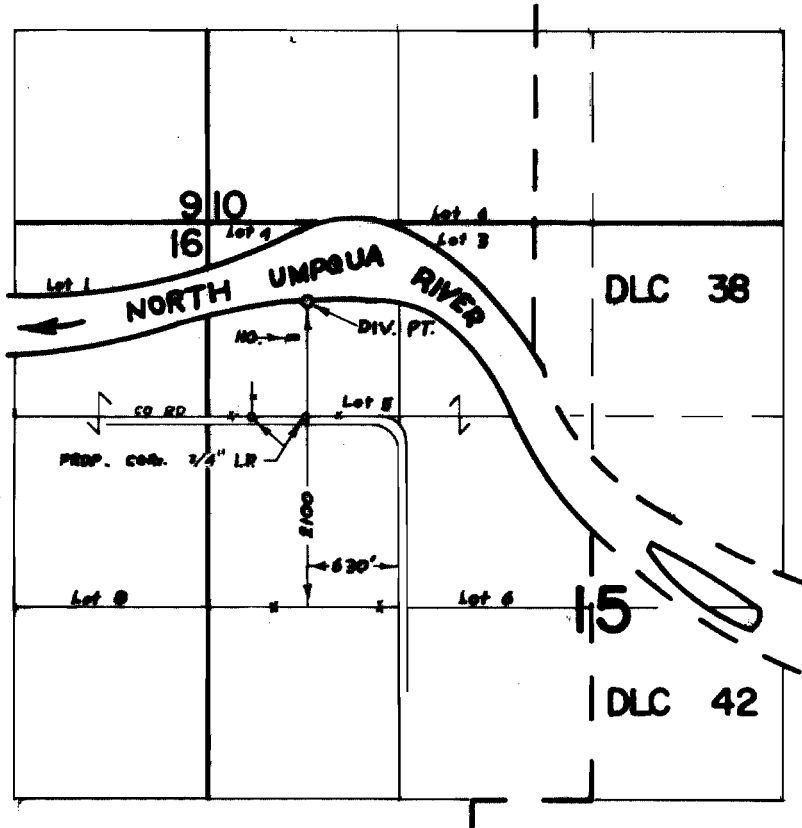

FINAL PROOF SURVEY
UNDER

Application No. 41552..... Permit No. 31196.....
IN NAME OF

OSCAR E. MILLER.....

Surveyed APR 12, 1971., by R. MUCKEN.....