


T. 26 S. R. 3 & 4 W. W. M.

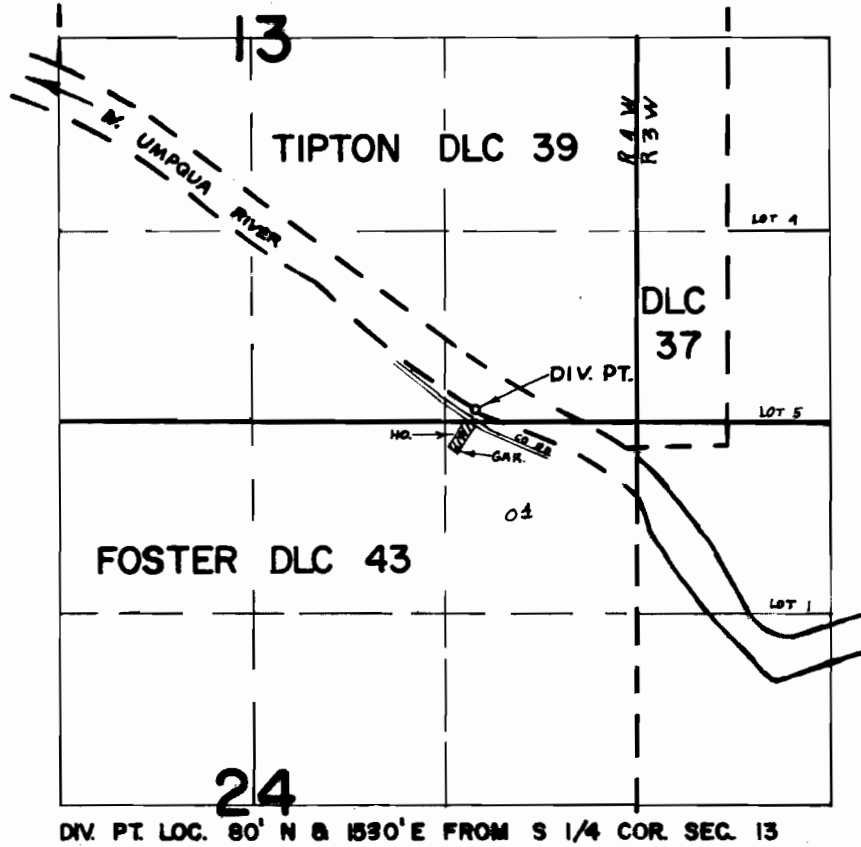

FINAL PROOF SURVEY
UNDER

Application No. 45990 Permit No. 34351
IN NAME OF

MRS. MARION E. FORTUNE

Surveyed APR. 12. 1971, by R. MUCKEN