


35090
C-38339

T. 7 S. R. 31 E. W. M.

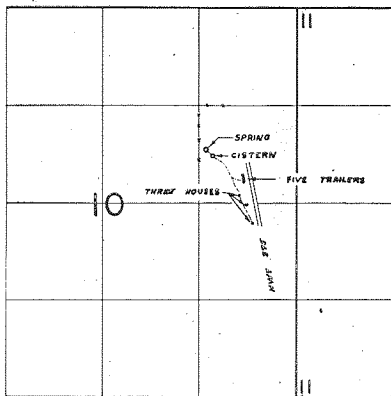

SPRING LOC. 600' S & 100' E FROM NW COR. SE 1/4 NE 1/4 SEC 10

FINAL PROOF SURVEY
UNDER

Application No. 46904. Permit No. 35090...
IN NAME OF

WILLIAM & OR CHARLOTTE ARBOGAST

Surveyed AUG. 24, 1971., by R. MUCKEN.....