


30722 4

T. I. N. R. IO E. W. M.

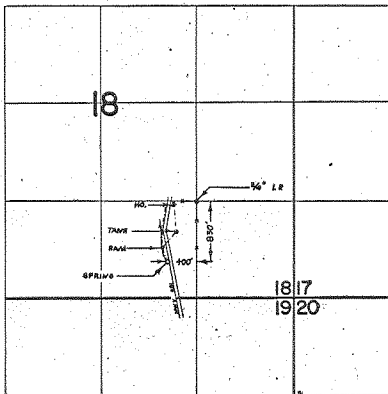

FINAL PROOF SURVEY UNDER

Application No. 41066 Permit No. 30722
IN NAME OF

RICHARD C. FRAZIER

Surveyed MAY 26, 1971, by R. MUCKEN

PLATE 4 - 11/11/71