


T. 3 4 S. R. 4 W. W. M. .

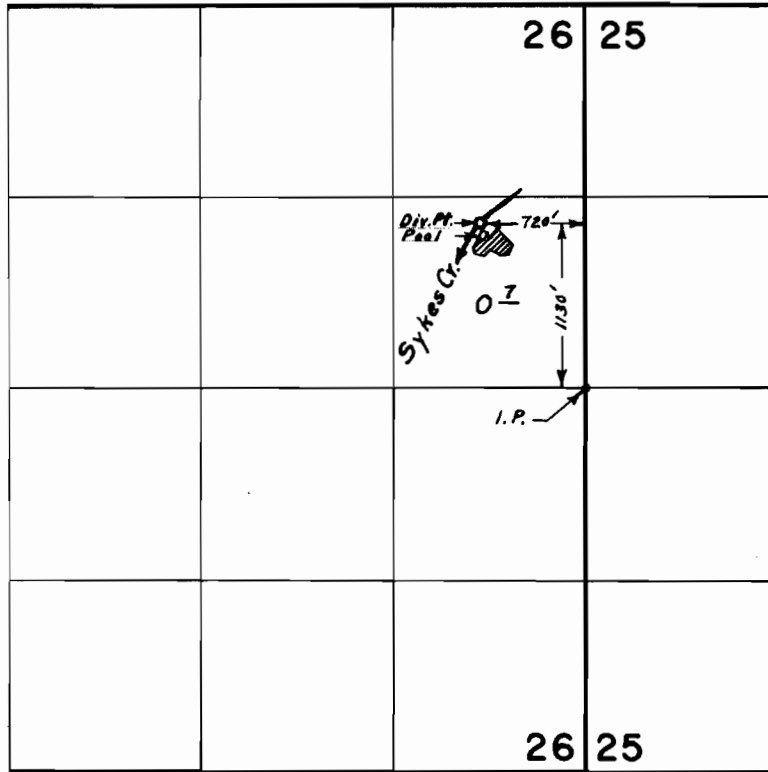

FINAL PROOF SURVEY
UNDER

Application No. 43402 Permit No. 32451

IN NAME OF
SISKIYOU FRATERNITY
AMERICAN SUN BATHERS ASSN.

Surveyed May 12, 1971, by L. E. Gould