


G-2554  
38344

# T. 35S. R. 12E. W. M.

Sycan to be Sycan Marsh well

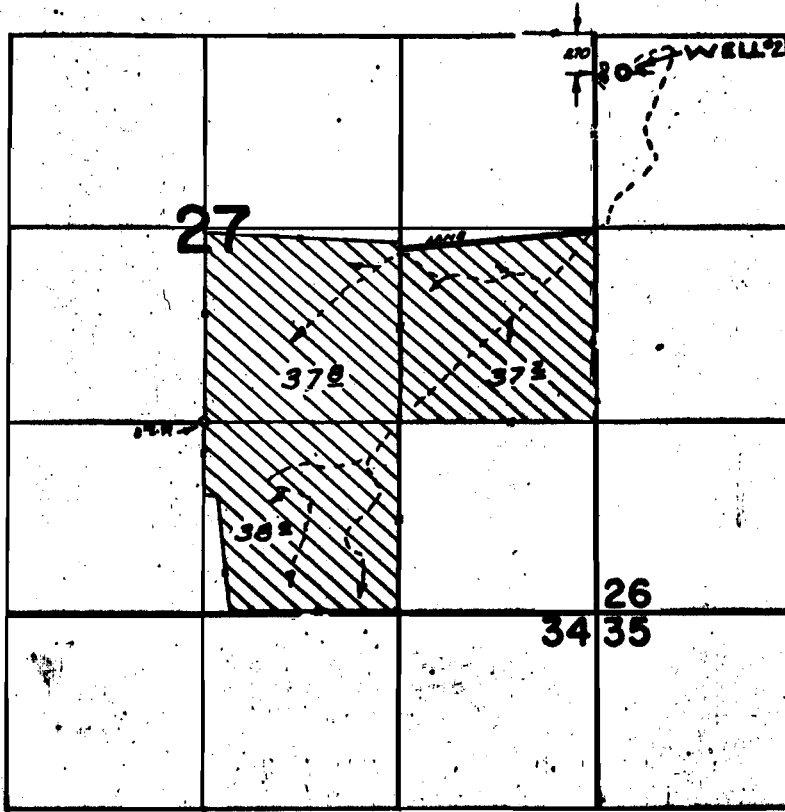

## FINAL PROOF SURVEY UNDER

Application No. G-2747. Permit No. G-2554

IN NAME OF  
ESTATE OF

GORDON G. STRATHEARN

Surveyed Mar. 16. 1970, by R. MURKIN.