


G-2870  
38345

# T.36S.R.13E.W.M.

Sprague for wells

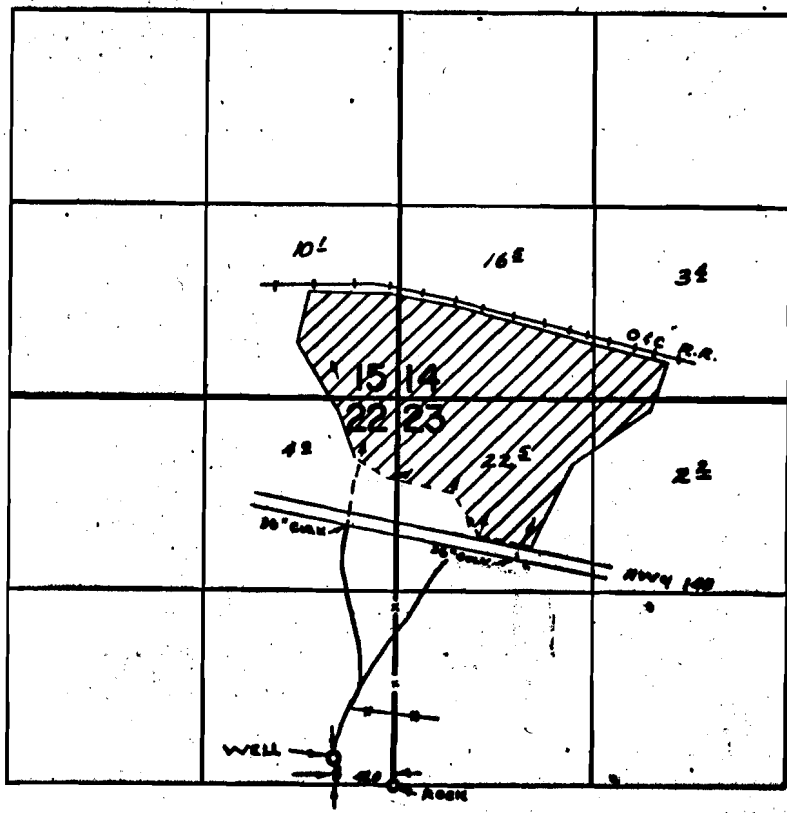

## FINAL PROOF SURVEY UNDER

Application No. G-3033 Permit No. G-2820  
IN NAME OF

FLOYD A. & LURA W. MARTIN

Surveyed MAY 12 1920, by R. MUCKEN