


Q 3465  
38346 19

# T. 40S. R. 10E. W. M.

East River Wells

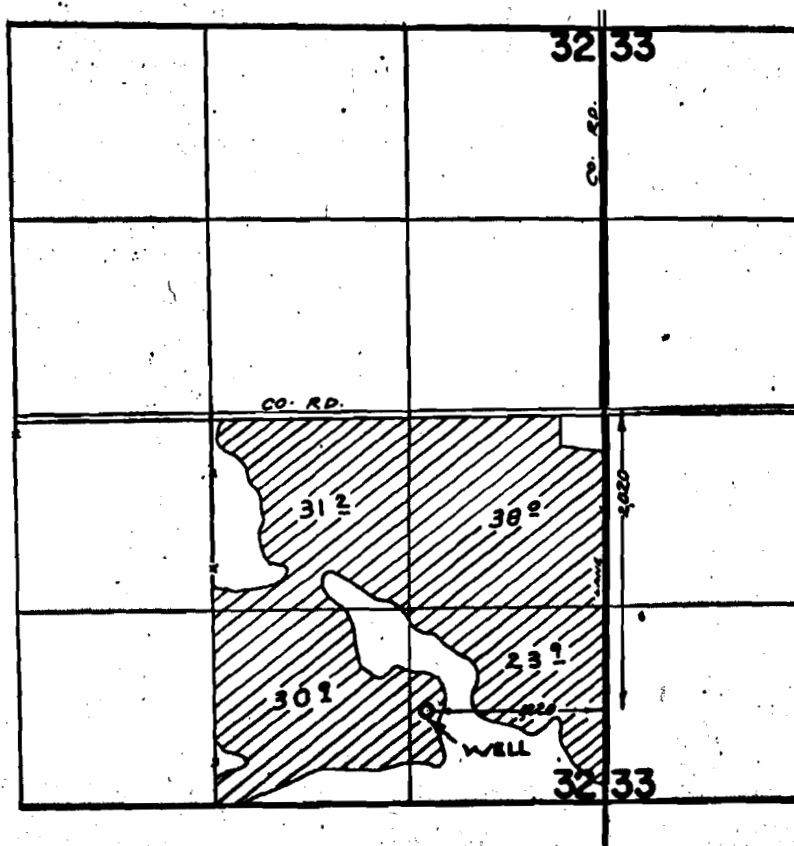

## FINAL PROOF SURVEY UNDER

Application No. G-3271 Permit No. G-3465  
IN NAME OF

VERNON M. GEARHARD

Surveyed SEP. 17 1971 by R. MUCKEN