


30519¹³
38348

T.40S.R.20E.W.M.

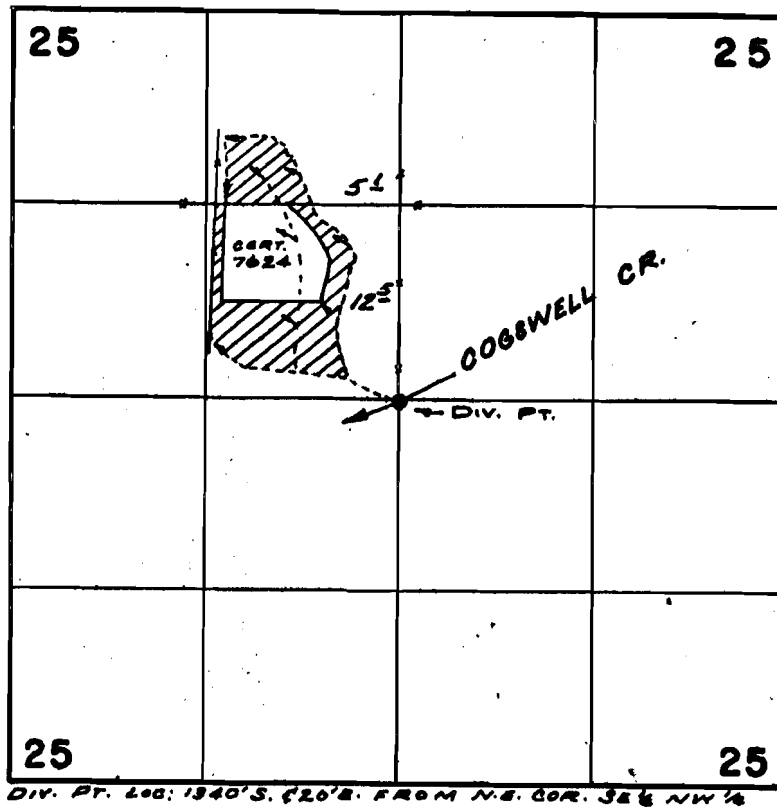

FINAL PROOF SURVEY

UNDER

Application No. 40883 Permit No. 30519

IN NAME OF

STEVE H. & IRENE M. BAILEY

Surveyed Aug. 13 1970, by R. MUCKEN

40-20✓