


T.40&41S.R.19E.W.M.

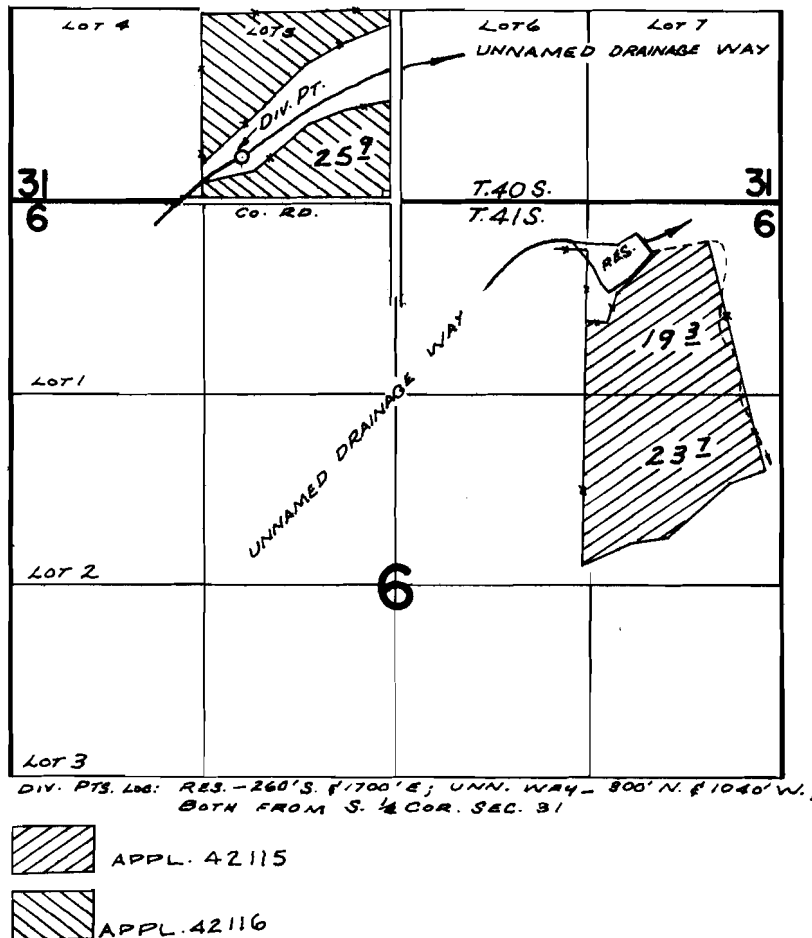

FINAL PROOF SURVEY

UNDER

Application No. R-42114 42115 42116 Permit No. R-4787 31538 31539

IN NAME OF

MILO L. CAIN

Surveyed AUG 30 19 70, by R. MUCKEN