


TOWNSHIP 2 N , RANGE 10 E , W. M.

North

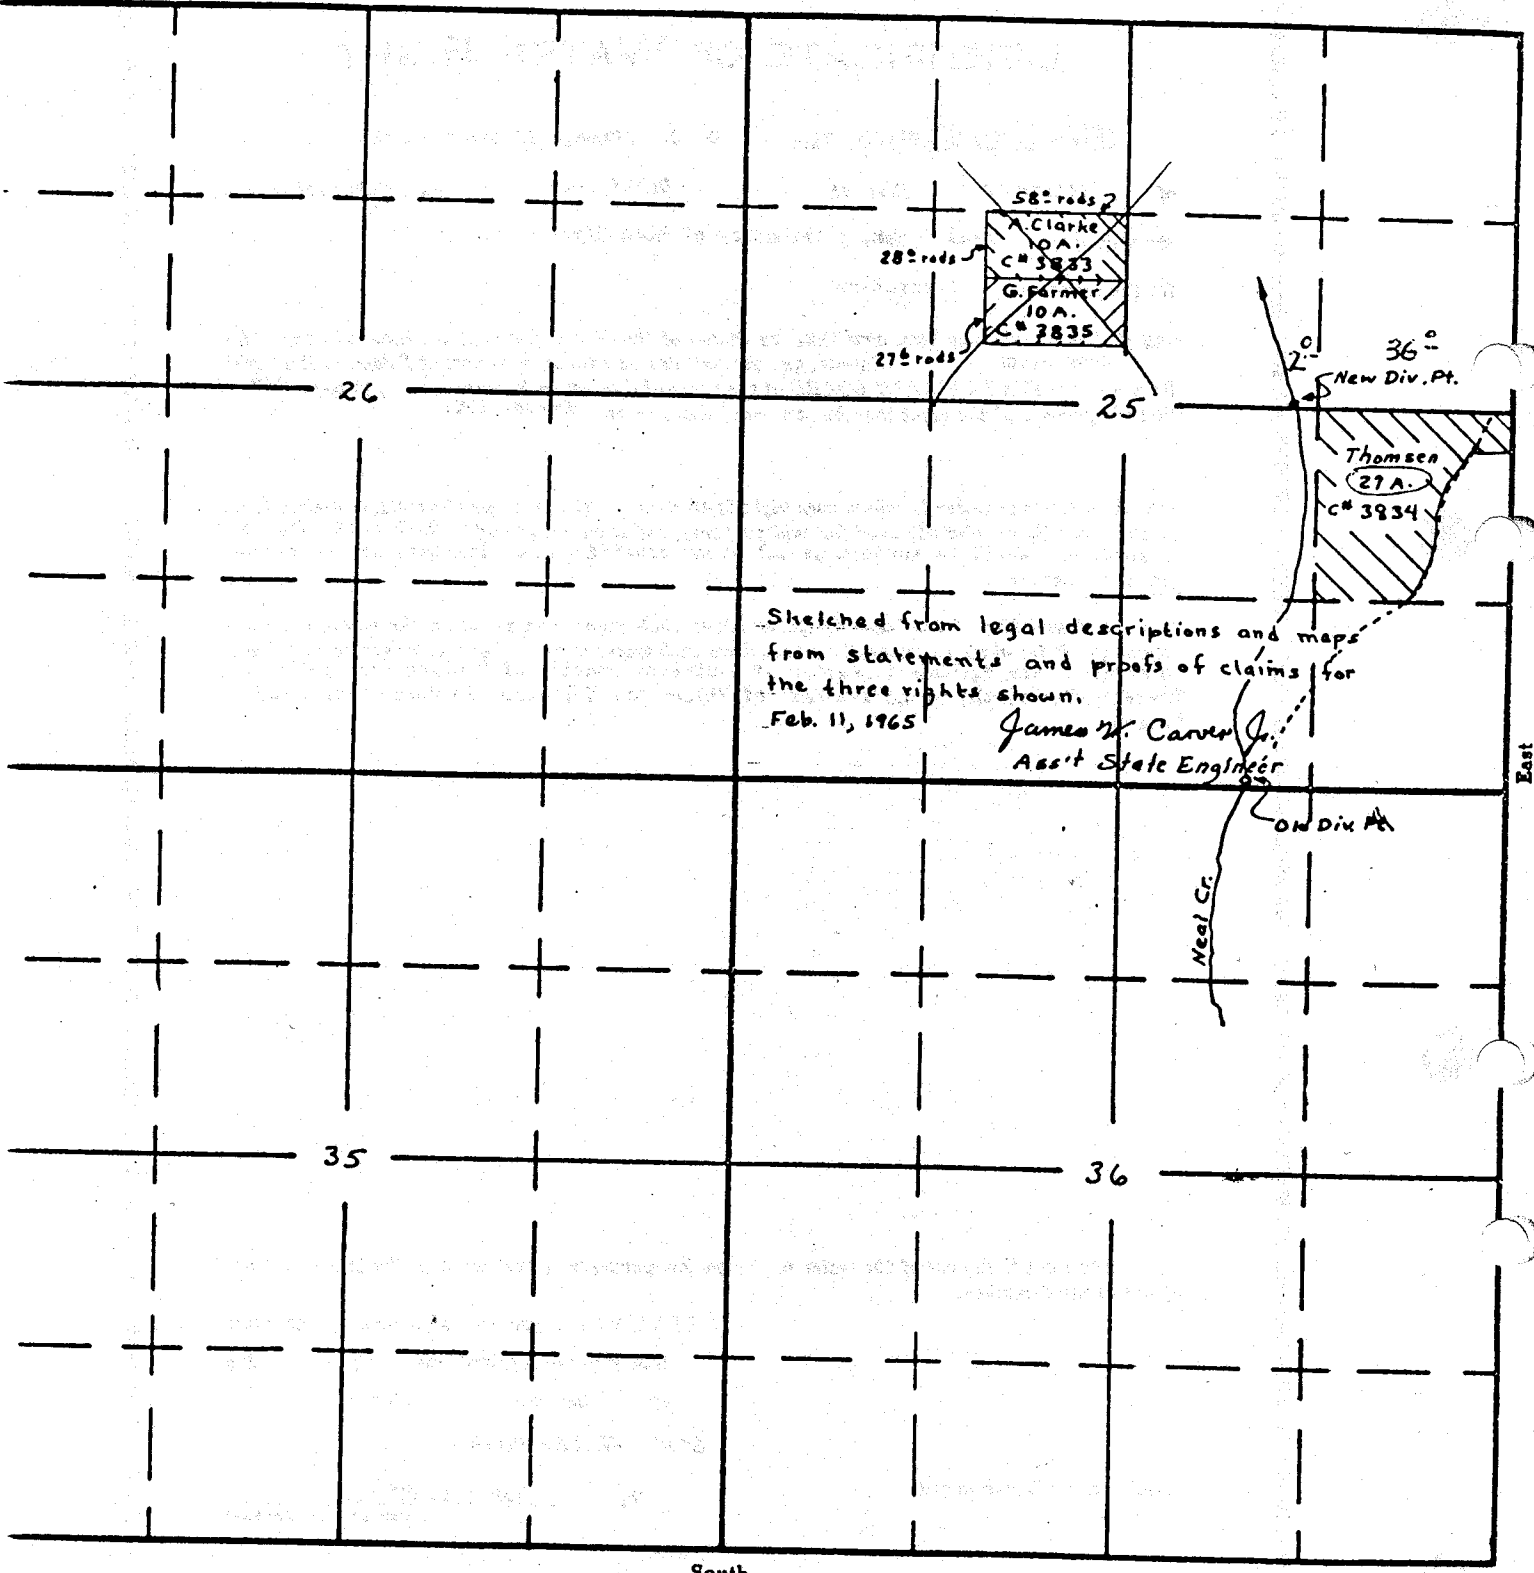

Sketched from legal descriptions and maps
from statements and proofs of claims for
the three rights shown.
Feb. 11, 1965

James W. Carver Jr.
Ass't State Engineer

South

APPLICATION No.
PERMIT No.

T-65