


31658¹³
38350

T.40S.R.19E.W.M.

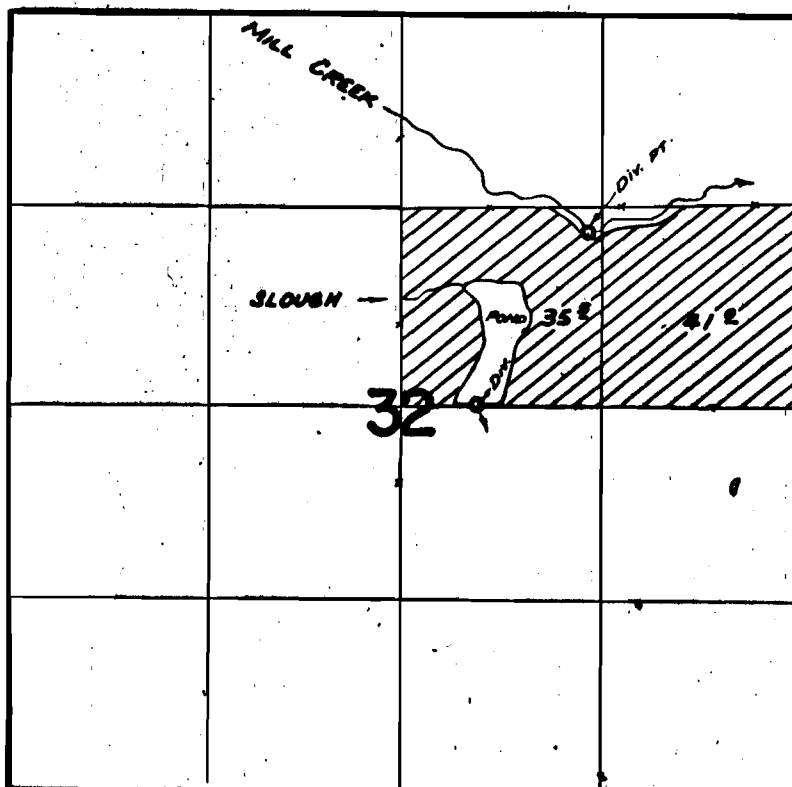

DIV. PTS. LOC: 1270'E. & 100'S. & 510'E. & 1350'S, BORN FROM NW COR.
S.W. & NE 1/4 SEC. 32

6-22-66

FINAL PROOF SURVEY
UNDER

Application No. 42172..... Permit No. 31658.....
IN NAME OF

WALTER D. THOMPSON & DONALD E. COX

Surveyed Aug. 12, 1970, by R. MUCKER.

40-19 ✓