


29504 13
R3962
38351

T.33S.R.18E.W.M.

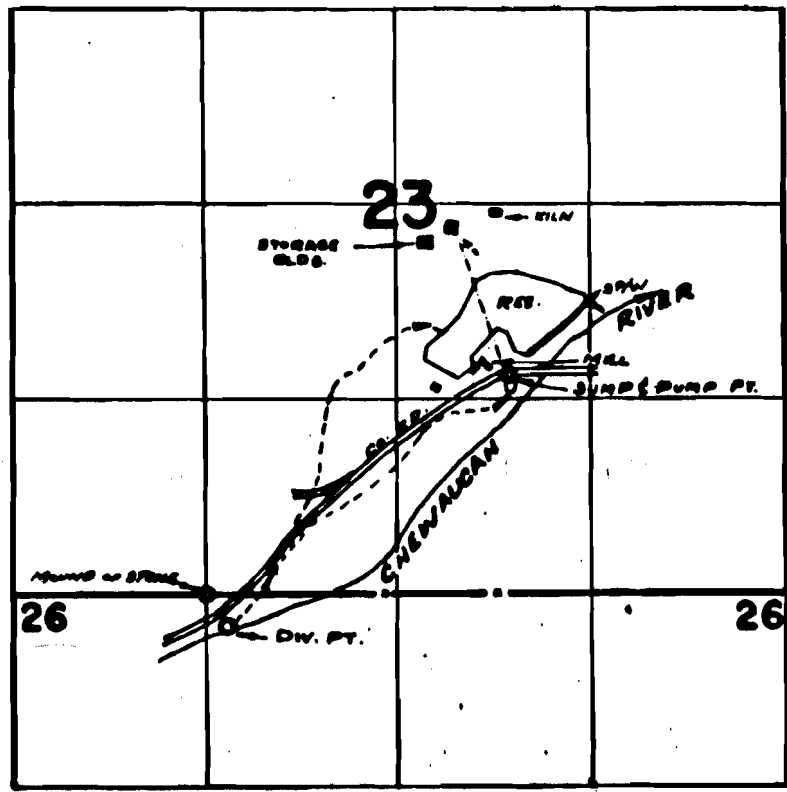

FINAL PROOF SURVEY

UNDER

Application No. ²⁹⁰⁰⁵~~A-3716~~ Permit No. ²⁹⁵⁰⁴~~A-3962~~....

IN NAME OF

OSTRANDER CONSTRUCTION COMPANY

Surveyed June 30 1910, by R. MUCKEN

3348 ✓