


29504 13
R3962
38352

T.33S.R.18E.W.M.

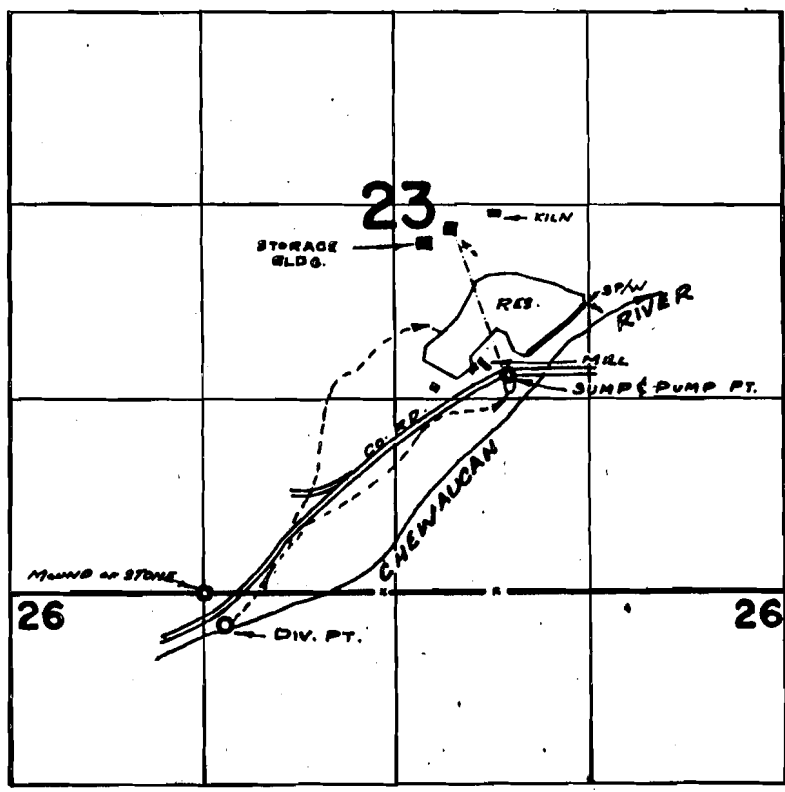

FINAL PROOF SURVEY

UNDER

Application No. ³⁹⁰⁰⁵~~R-39116~~ Permit No. ²⁹⁵⁰⁴~~R-3962~~

IN NAME OF

OSTRANDER CONSTRUCTION COMPANY

Surveyed JUNE 30 1970, by R. MUCKEN

Handwritten initials