


T.15S.R.4W.W.M.

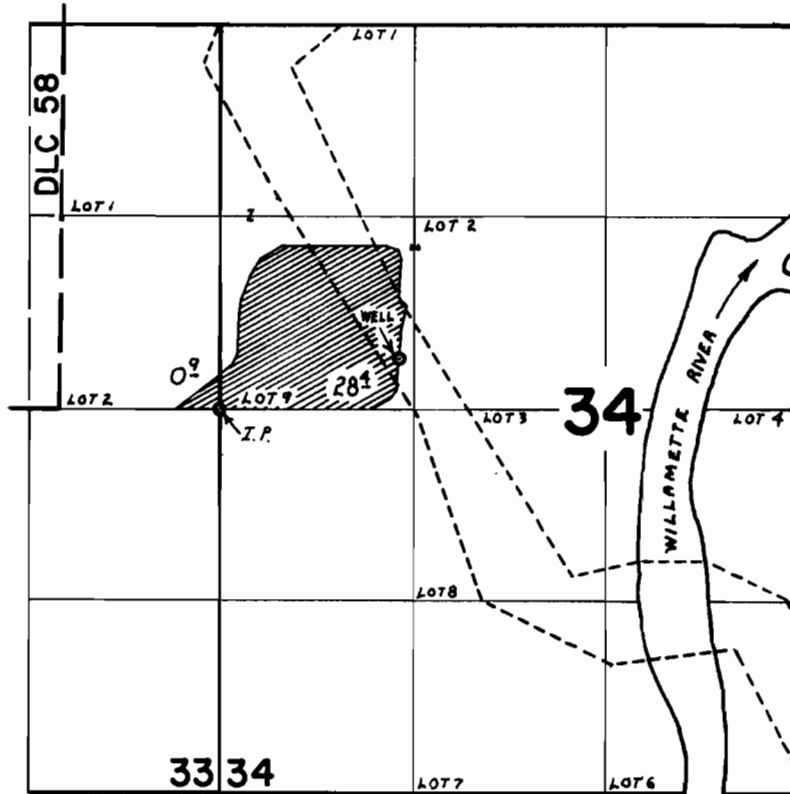

WELL LOC. 340' N. & 1230' E. FROM W. 1/4 COR. SEC. 34

FINAL PROOF SURVEY

UNDER

Application No. G-3555 Permit No. G-3344

IN NAME OF

BENNIE JENSEN

Surveyed AUG. 29 1970, by L.E. GOULD