


T. 15 S. R. 5 W. W. M.

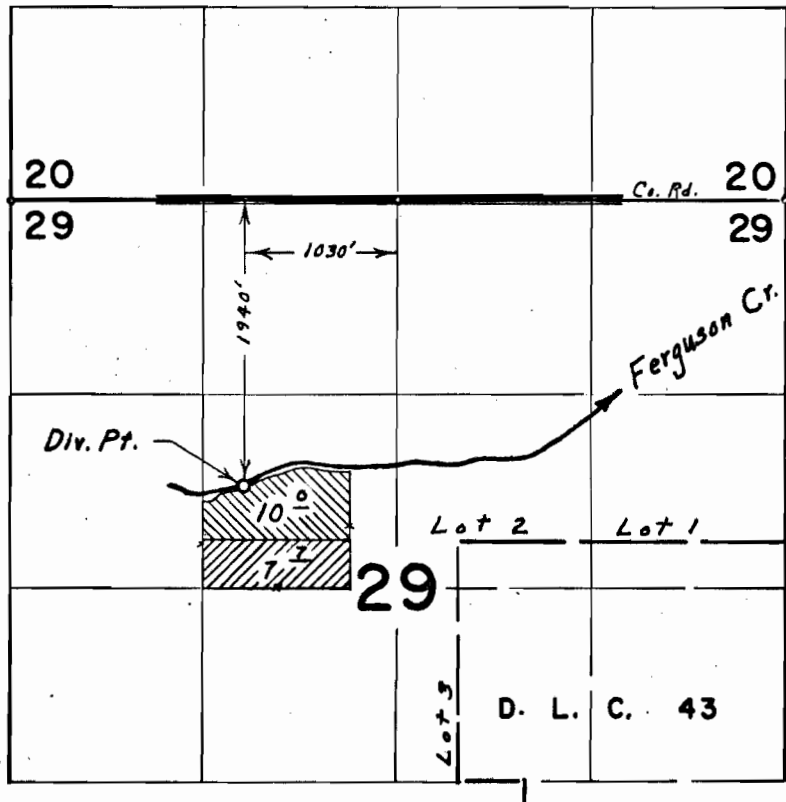

FINAL PROOF SURVEY
UNDER

Application No. 44943 43175 Permit No. 33590 32273
IN NAME OF

DALE W. MOFFETT

Surveyed Aug. 28, 1970, by L. E. Gould