


T.18S.R.1W.W.M.

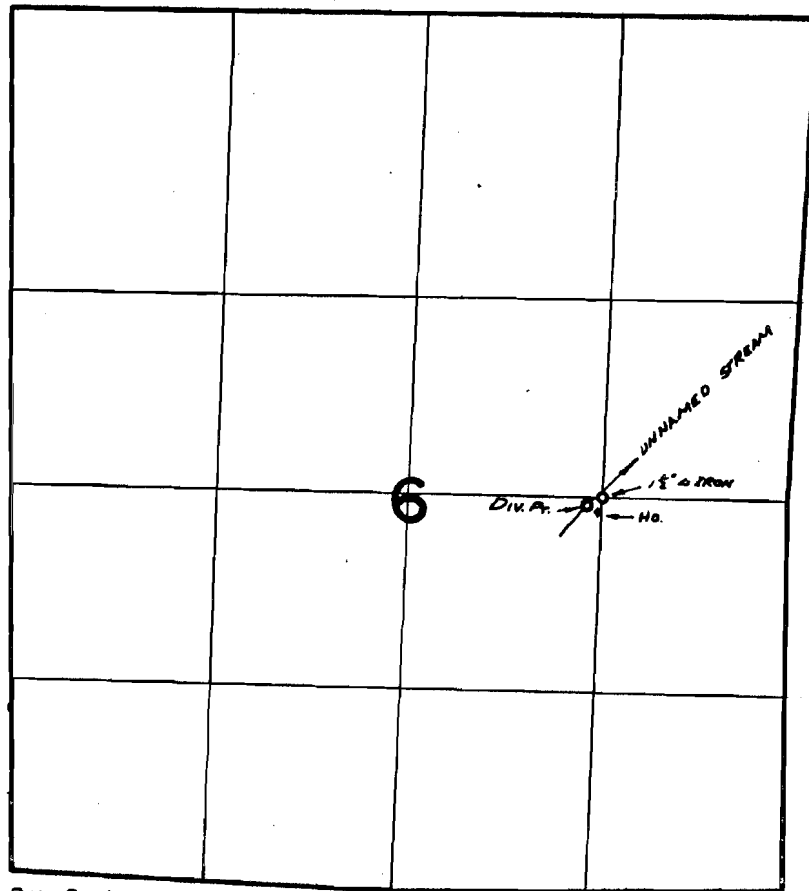

DIV. PT. LOC: 50'S. & 90'W. FROM N.E. COR. NW 1/4 SE 1/4 Sec. 6

FINAL PROOF SURVEY

UNDER

Application No. 44530 Permit No. 33341

IN NAME OF

KAROL L. STUCKY

Surveyed OCT. 13 19 70, by R. MUCKEN