


T. 6 S. R. 2 W. W. M.

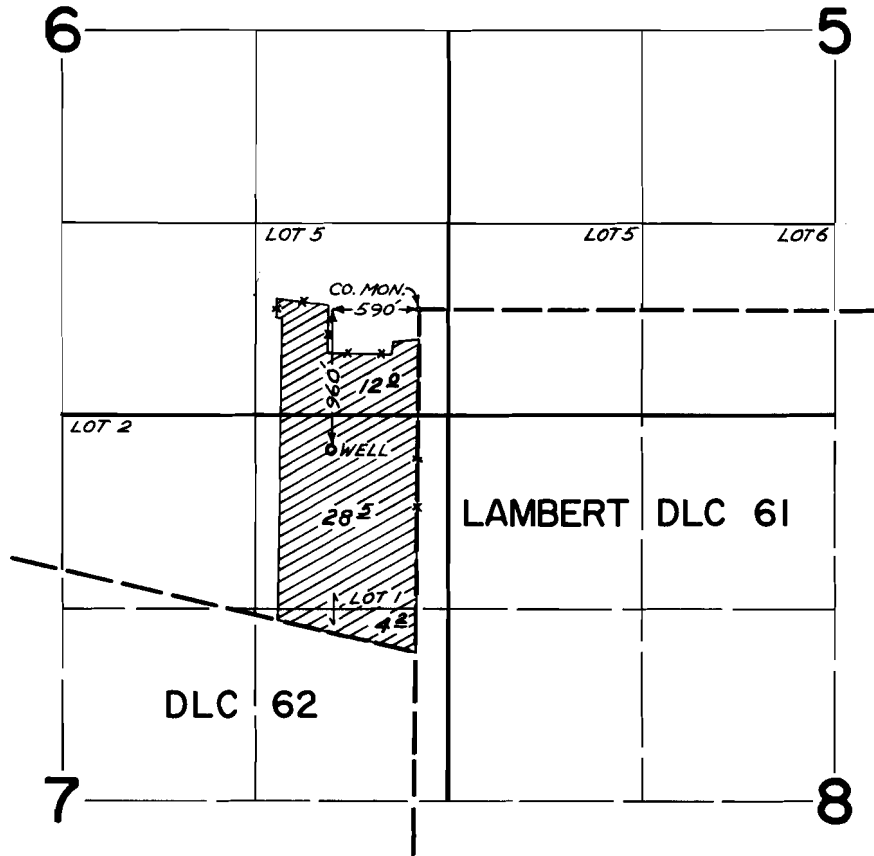

FINAL PROOF SURVEY
UNDER

Application No. G-3040 Permit No. G-2836
IN NAME OF

ISAY J. GRIGORIEFF

Surveyed JULY 7, 1971, by GREG BACA