


T. 6 S. R. 2 W. W. M.

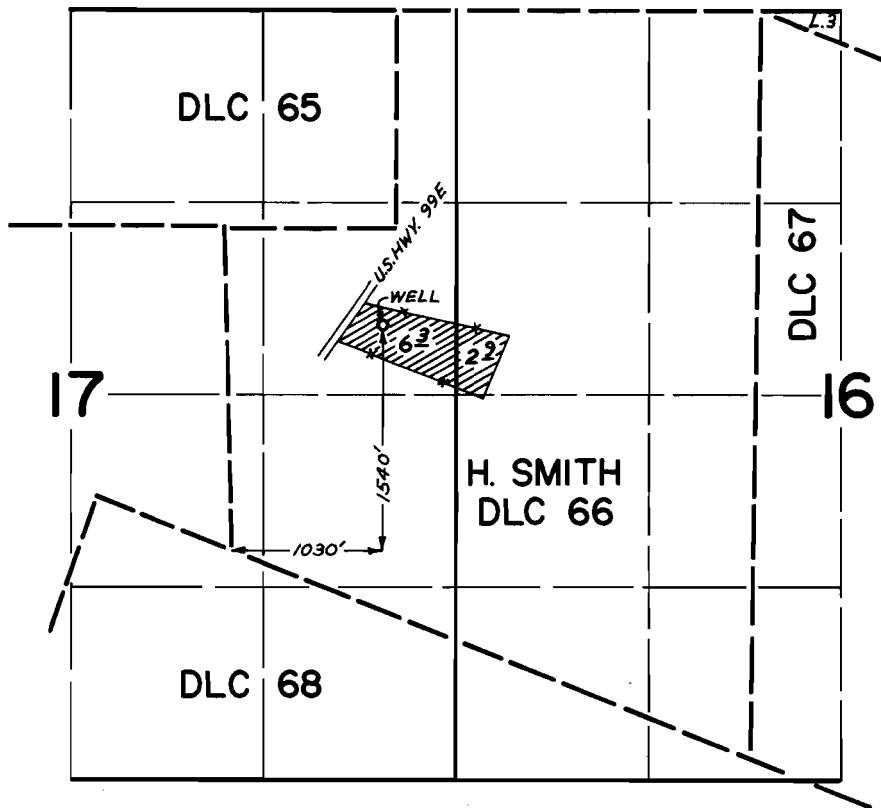

**FINAL PROOF SURVEY**  
UNDER

Application No. G-3318 Permit No. G-3119  
IN NAME OF

JOHN J. SAIN

Surveyed JULY 7 1971, by GREG BACA