


T. 4 S. R. 2 W. W. M.

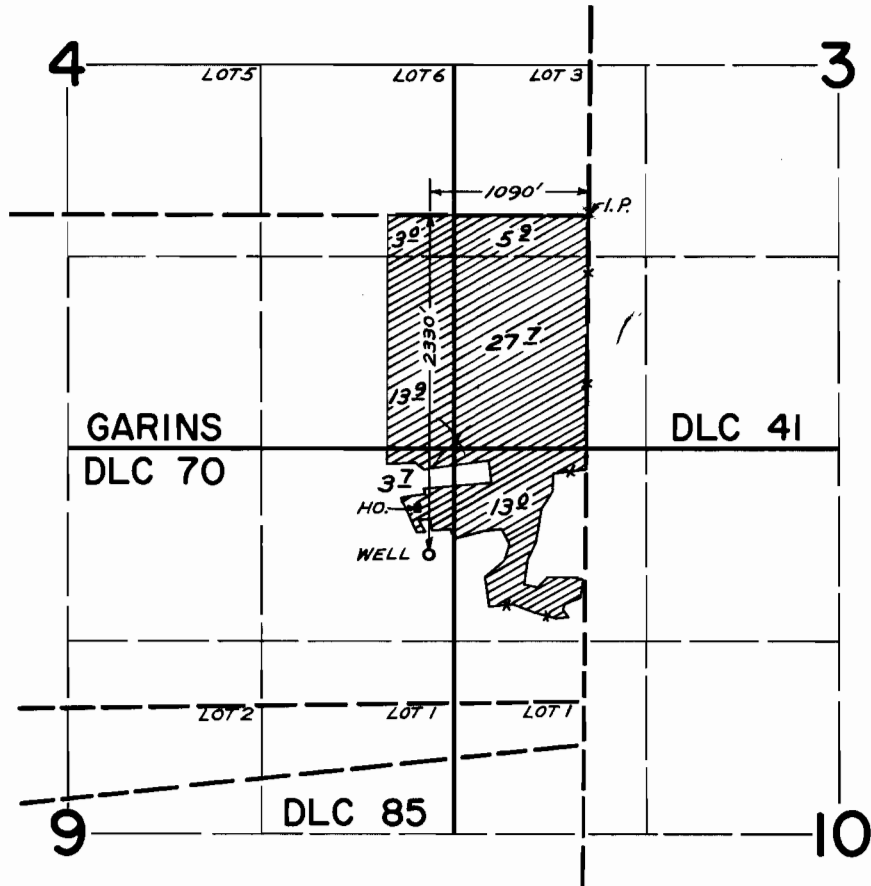

FINAL PROOF SURVEY
UNDER

Application No. G-3485 Permit No. G-3285
IN NAME OF

AMIEL DESMET

Surveyed AUG. 18 1971, by GREG BACA