


T. 4 S. R. 1 W. W. M.

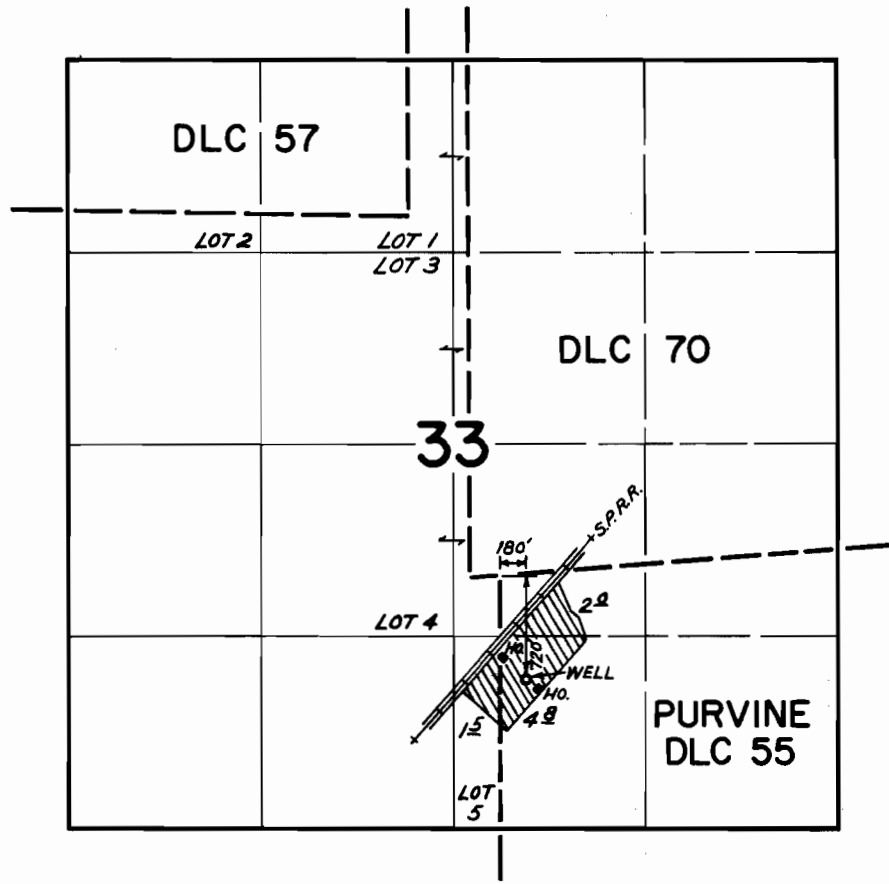

**FINAL PROOF SURVEY**  
UNDER

Application No. G-3957 Permit No. G-3352  
IN NAME OF

GEORGE A. SANDERS

Surveyed JULY 14 1971, by GREG BACA