


T. 6 S. R. 2 W. W. M.

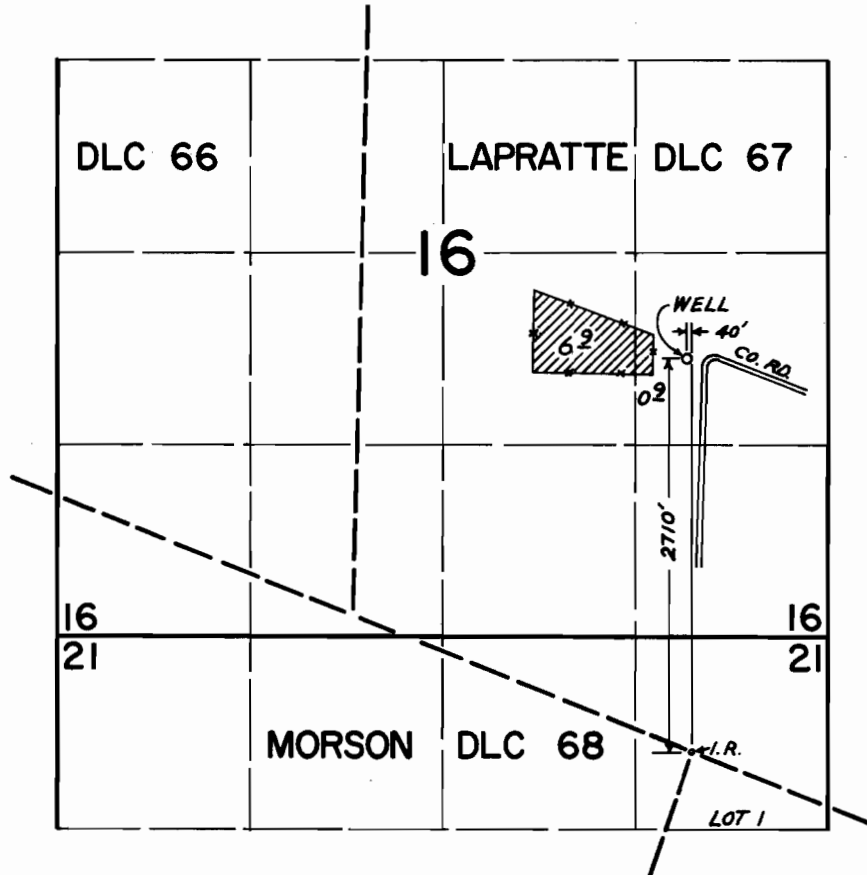

FINAL PROOF SURVEY
UNDER

Application No. G-4002 Permit No. G-3754
IN NAME OF

ROBERT C. AUSTIN

Surveyed JULY 26, 1971, by GREG BACA