


T. 6 S. R. 2 W. W. M.

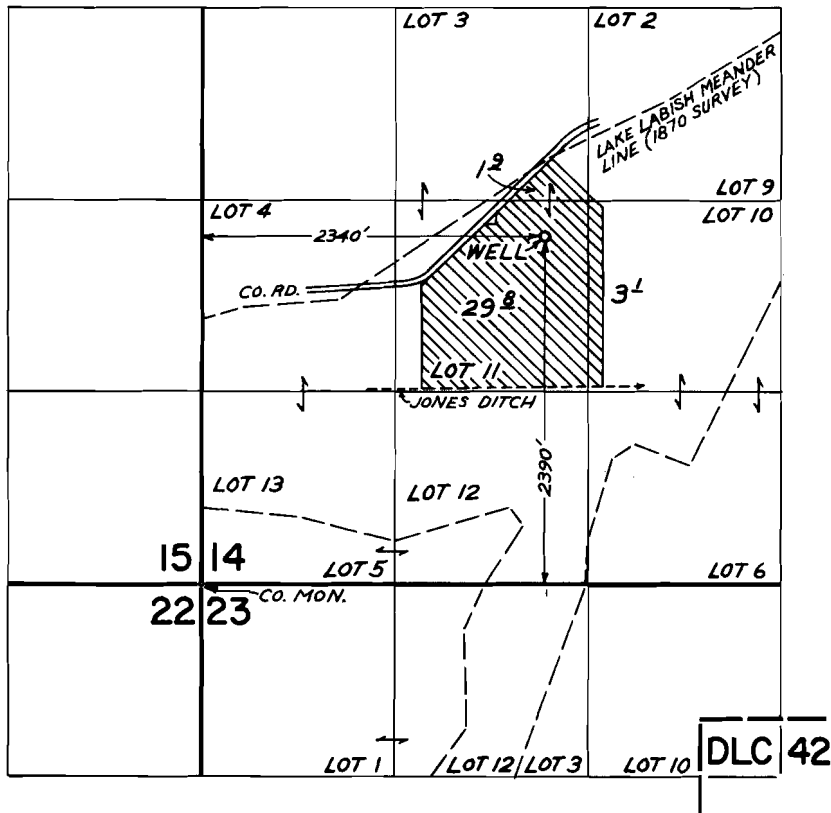

FINAL PROOF SURVEY UNDER

Application No. G-4113... Permit No. G-3861...
IN NAME OF

JOHN H. BISANZ

Surveyed JULY 27, 1971., by GREG BACA...