


T. 4 S. R. 1 & 2 W. W. M.

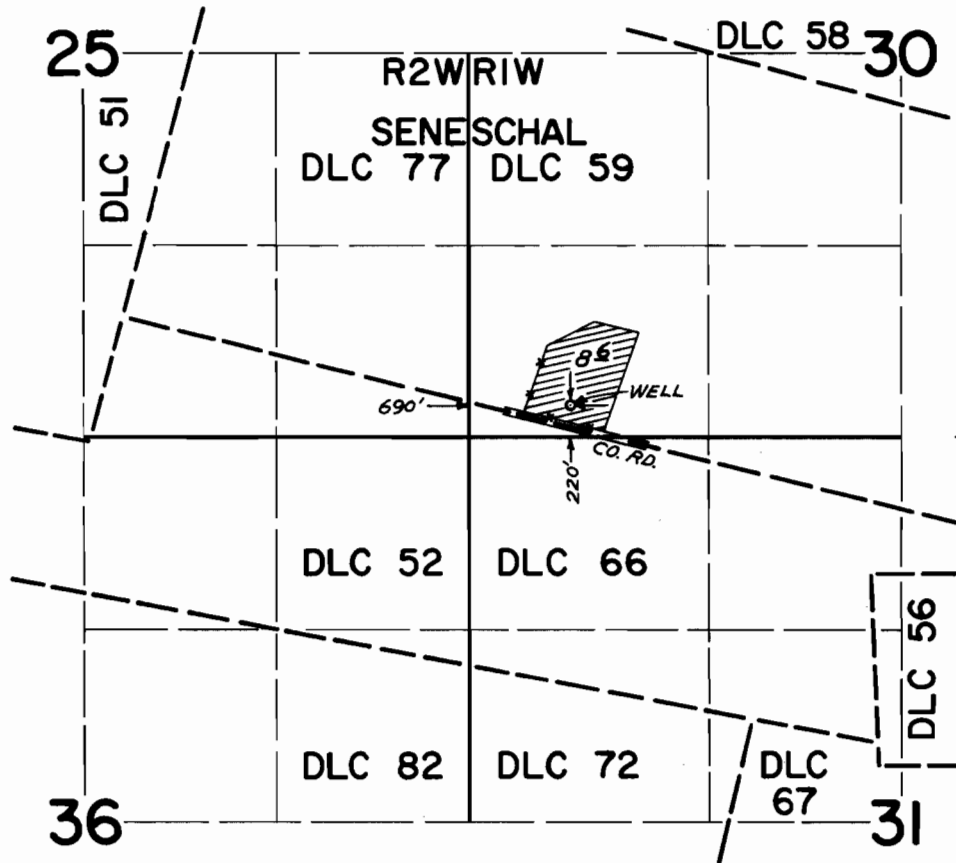

**FINAL PROOF SURVEY**  
UNDER

Application No. G-4682 Permit No. G-4407  
IN NAME OF

A. & M. C. PALACIOS

Surveyed JULY 30 1971, by GREG BACA