


T. 4 S. R. 1 W. W. M.

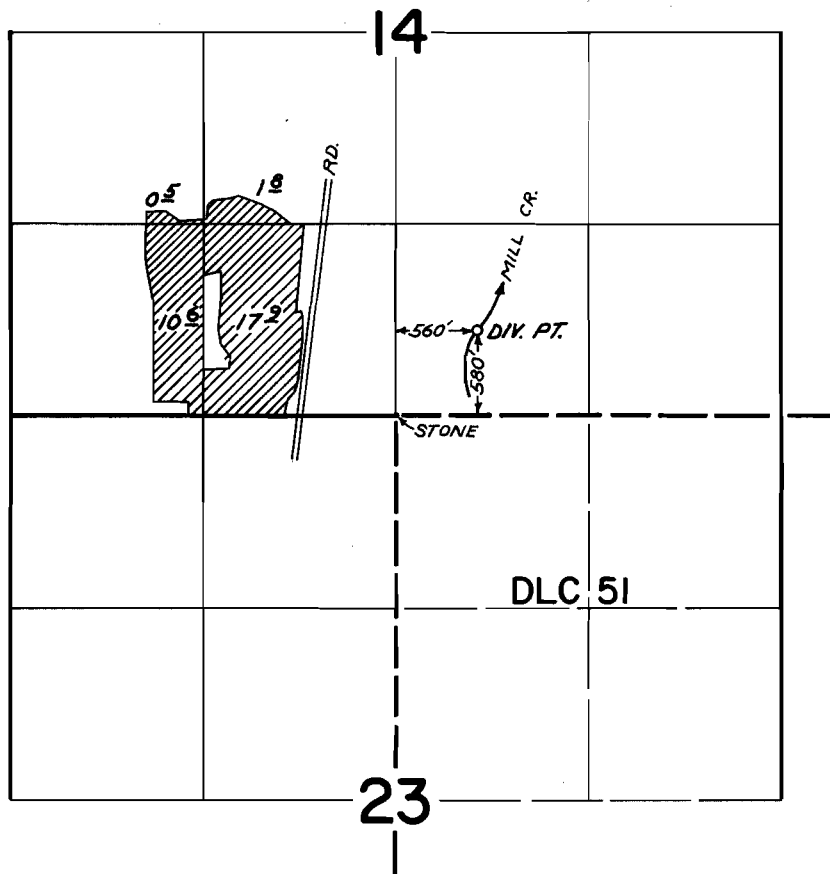

FINAL PROOF SURVEY UNDER

Application No. 43762 Permit No. 32705
IN NAME OF

RAY M. KOENIG

Surveyed AUG. 19 1971, by GREG BACA