


T.7S. R.1W. W.M.

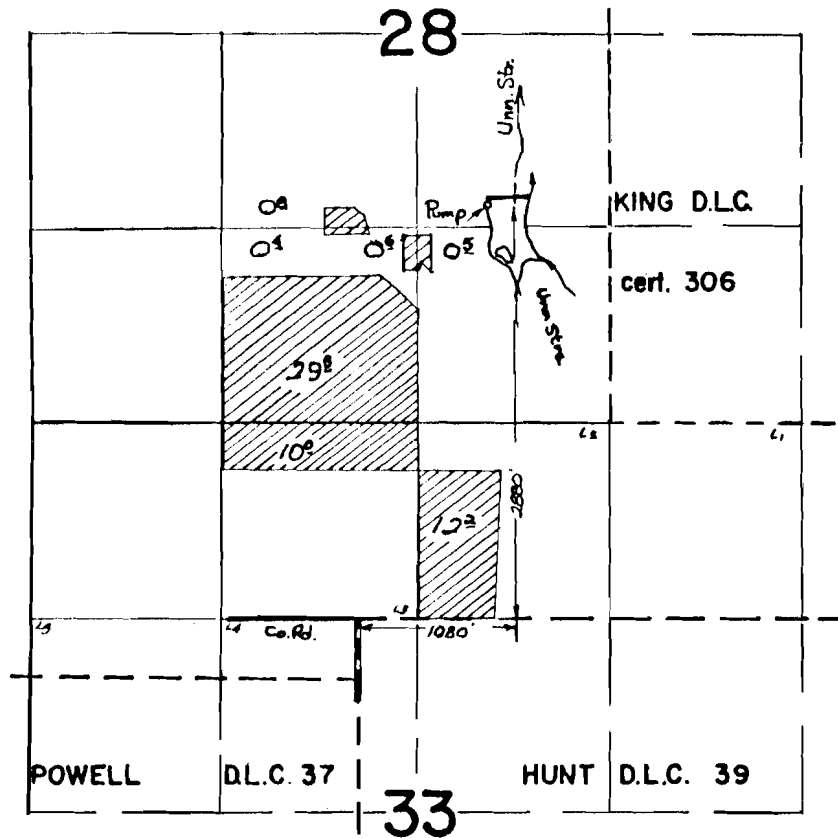

FINAL PROOF SURVEY
UNDER

R 40533 R 4731
Application No. 40534 Permit No. 31250
IN NAME OF

LEE A. KUENZI

Surveyed 26, 27 APR 1971, by G. BACA