


T. 7 S. R. 1 W. W. M.

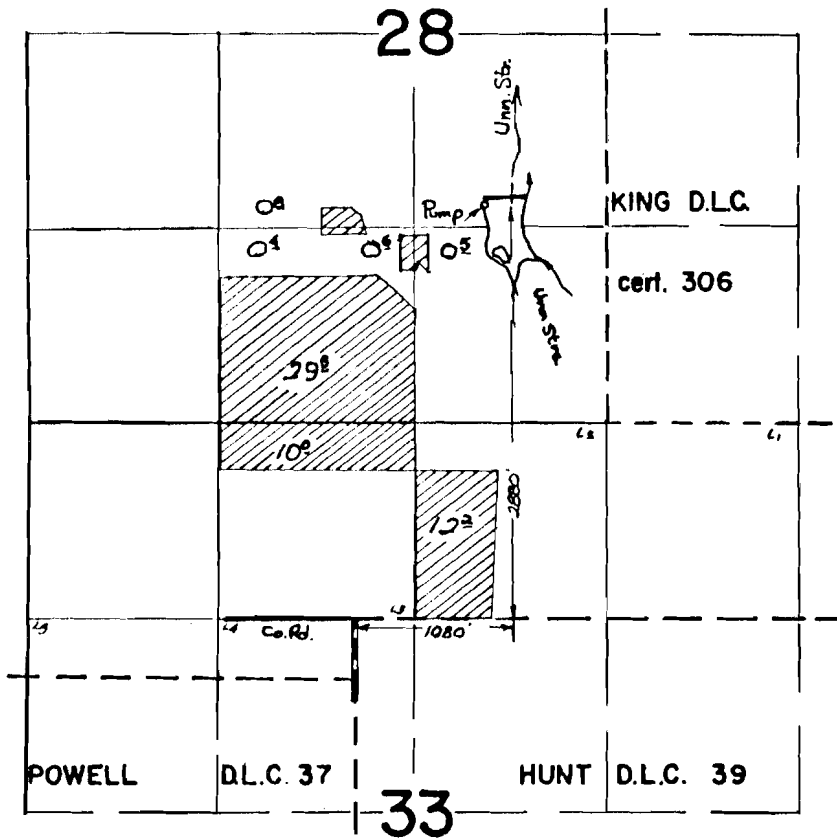

FINAL PROOF SURVEY
UNDER

Application No. 40534 Permit No. 31250
IN NAME OF

LEE A. KUENZI

Surveyed 26, 27 APR 1971, by G. BACA.....