


T. I. S. R. 24 E. W. M.

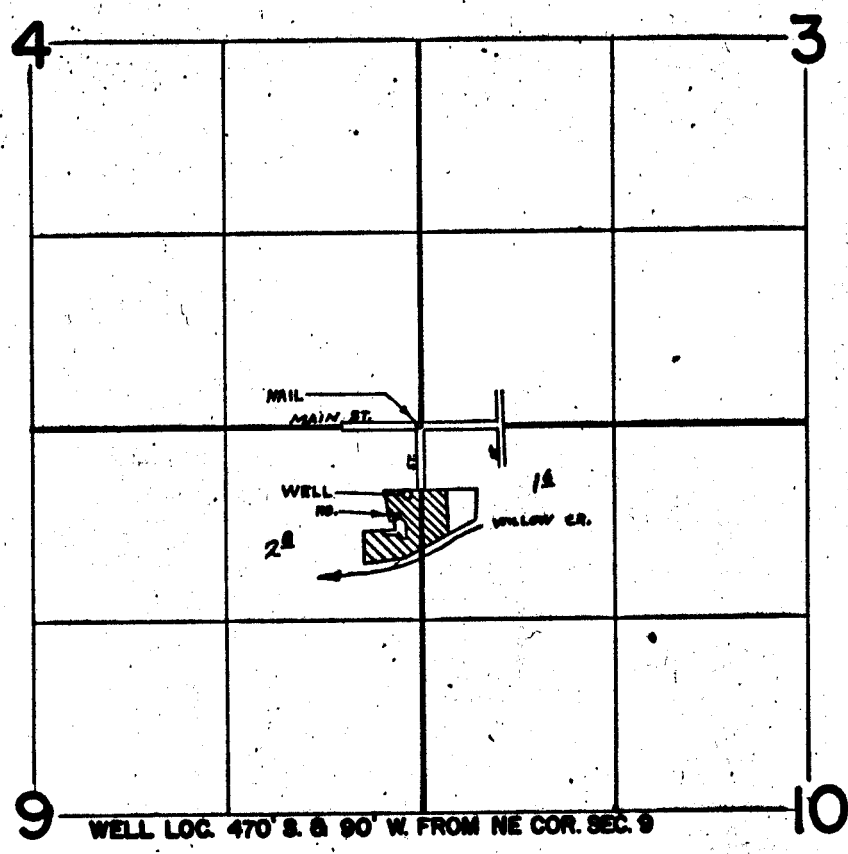

FINAL PROOF SURVEY UNDER

Application No. G. 4624 Permit No. G. 4329
 IN NAME OF
HAROLD RIETMANN
 Surveyed MAY 7, 1971, by R. MUCKEN