


T. 2 S. R. 26 E. W. M.

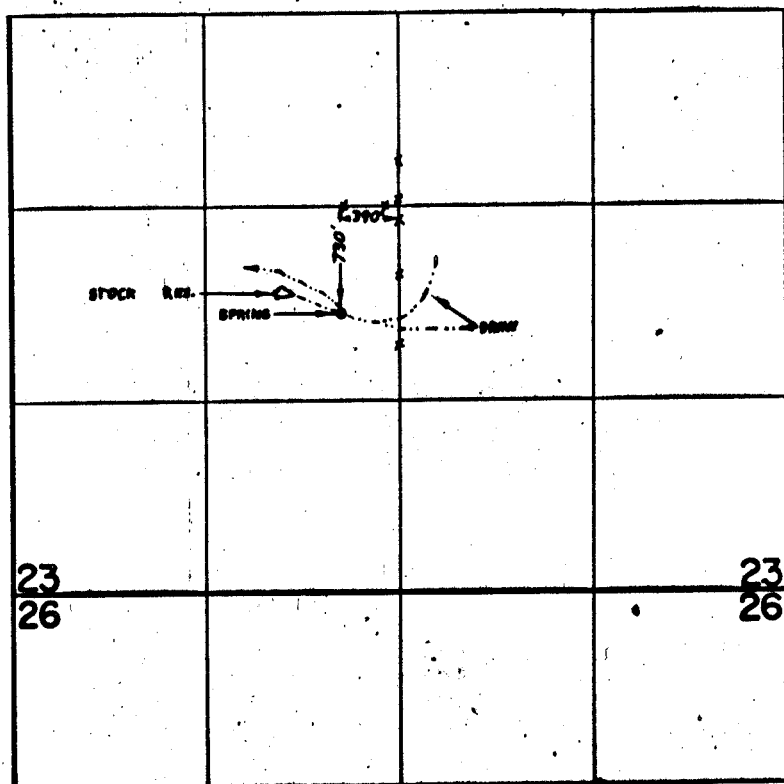

FINAL PROOF SURVEY UNDER

Application No. 40791..... Permit No. 30528.....
IN NAME OF

.....J. E. LoTRACE.....

Surveyed MAY 4, 1971, by R. MUCKEN.....