


C 38374

T.38&4S.R.14E.W.M.

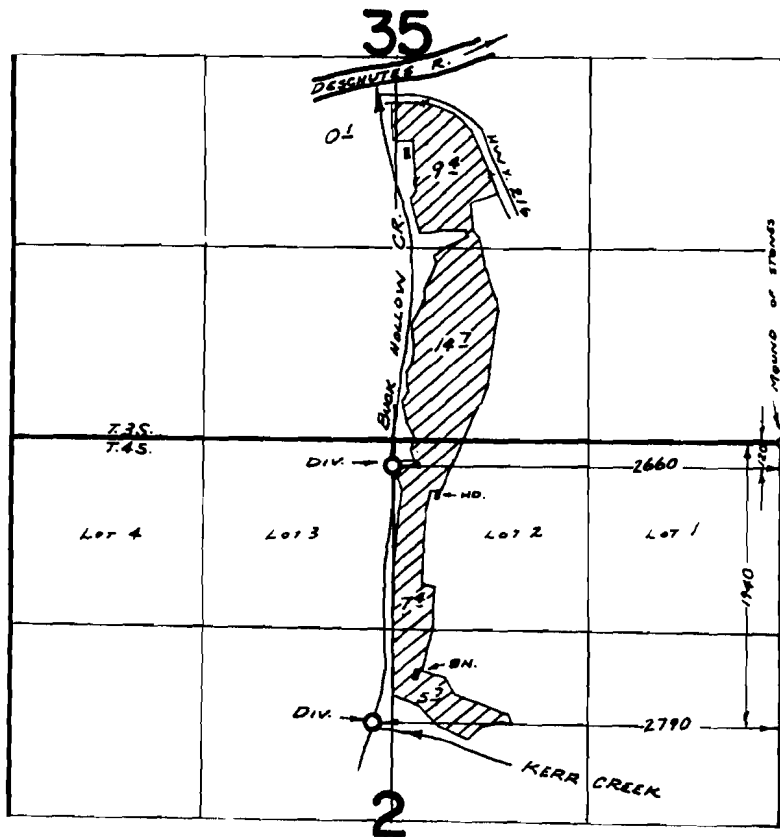

FINAL PROOF SURVEY

UNDER

Application No. 38284 Permit No. 28518

IN NAME OF

ERNEST O. & AGNES M. WEBB

Surveyed Oct. 22, 1970, by R. MUCKEN