


T. 5 S. R. 9 W. W. M.

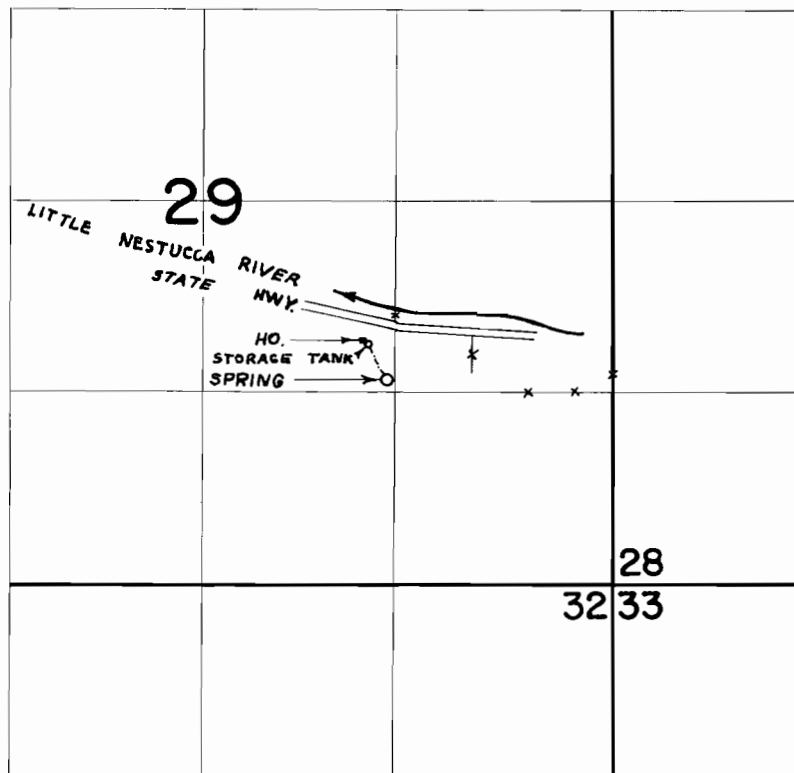

SPRING LOC. 60' N & 1540' W FROM SE COR. NE 1/4 SE 1/4 SEC. 29

FINAL PROOF SURVEY
UNDER

Application No. 41238..... Permit No. 30754...
IN NAME OF

.....ALAN K. BURPEE.....

Surveyed AUG. 11, 1971, by R. MUCKEN.....