


T I S. R. 10 W. W. M.

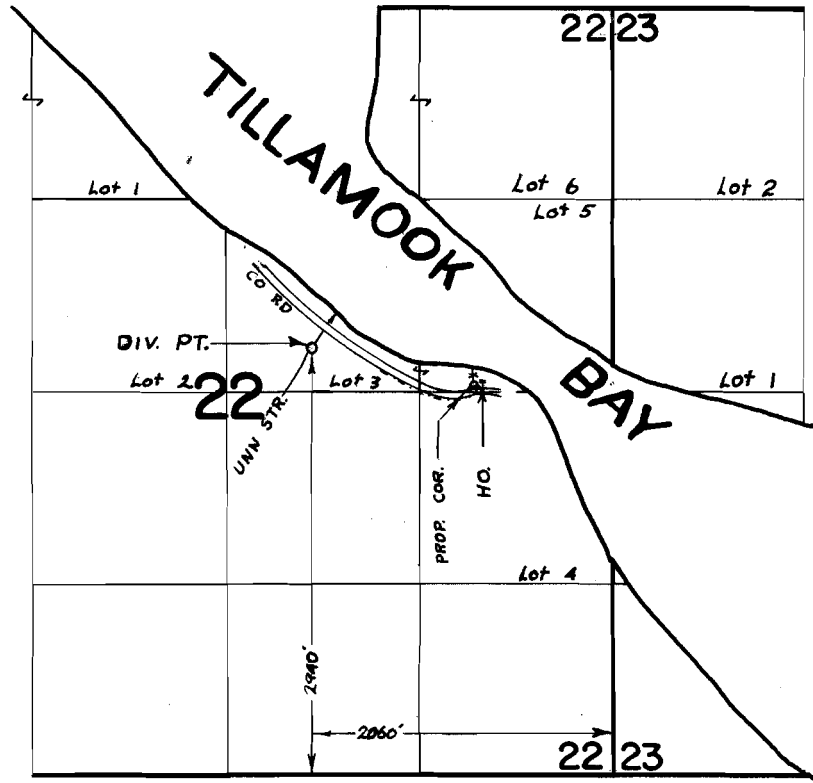

FINAL PROOF SURVEY UNDER

Application No. 43978... Permit No. 32852.....
IN NAME OF

JOHN M. & MARGARET A. McNICHOLAS

Surveyed AUG. 5, 1971, by R. MUCKEN.....