


T. 3 S. R. 8 W. W. M.

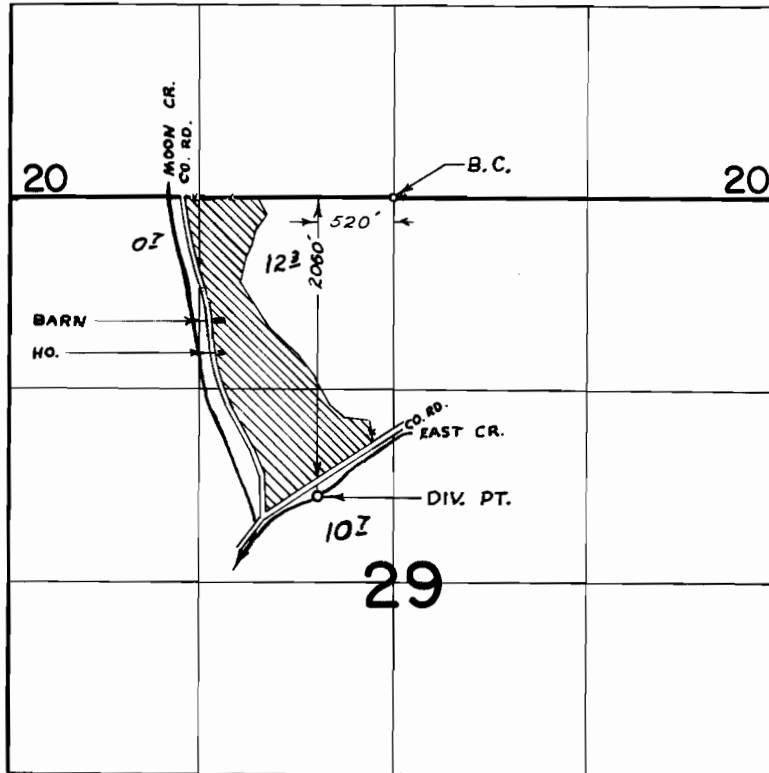

FINAL PROOF SURVEY UNDER

Application No. 44868... Permit No. 33277...
IN NAME OF

LLOYD FLETCHER

Surveyed AUG. 13... 1971., by R. MUCKEN.....