


T. 4 S. R. 10 W. W. M.

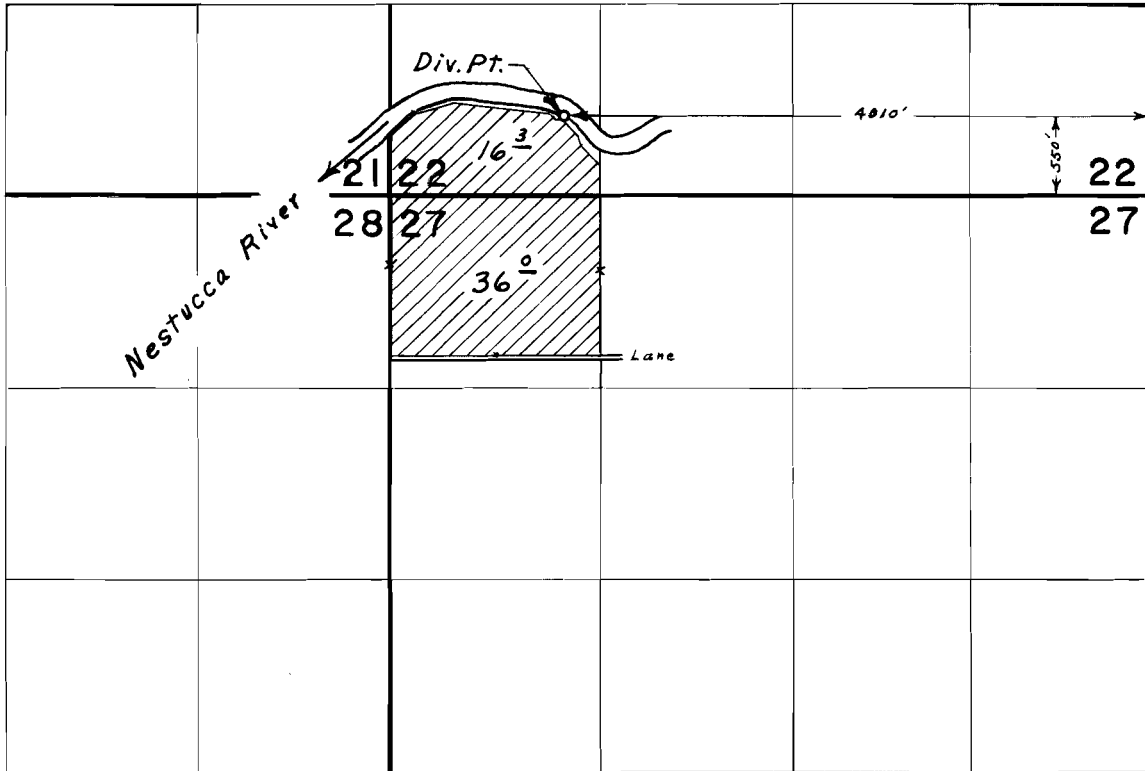

FINAL PROOF SURVEY UNDER

Application No. 45122 Permit No. 33717
IN NAME OF

MEADOW VIEW DAIRIES

Surveyed Aug. 12, 1971, by L. E. Gould