


T. 4 S. R. 10 W. W. M.

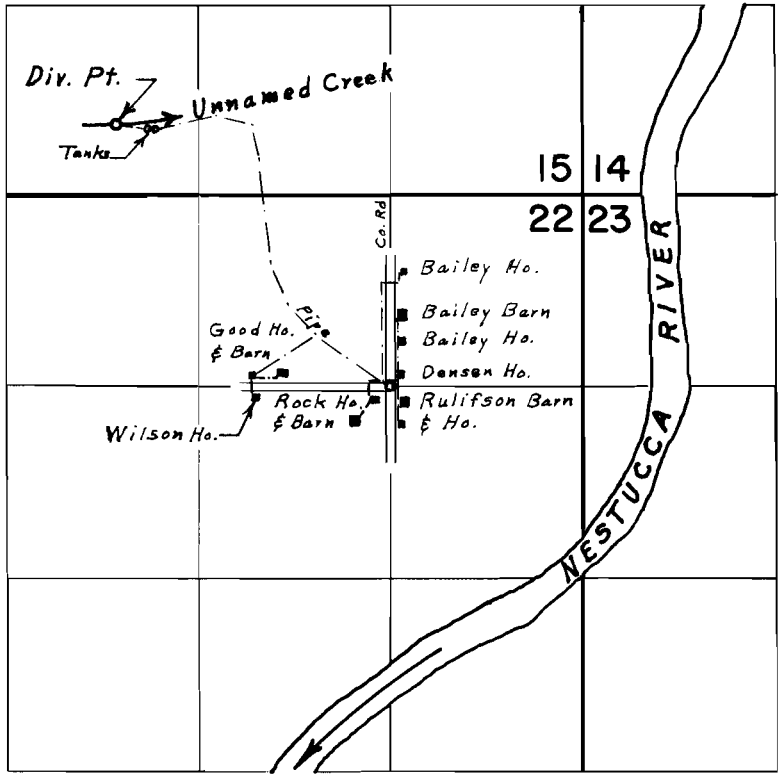

Div. Pt. located 1790' N. & 1890' W. from S.E. Cor. N.W. 1/4 N.E. 1/4 Sec. 22

FINAL PROOF SURVEY UNDER

Application No. 46279 Permit No. 34572
 IN NAME OF
**GOLDIE WILSON, WILFORD ROCK, ROBERT L. RULIFSON,
 MAYNARD DENSON, DONELL BAILEY, & LEE GOOD**

Surveyed Aug. 11, 1971, by L. E. Gould.