


T I S. R. 9 W. W. M.

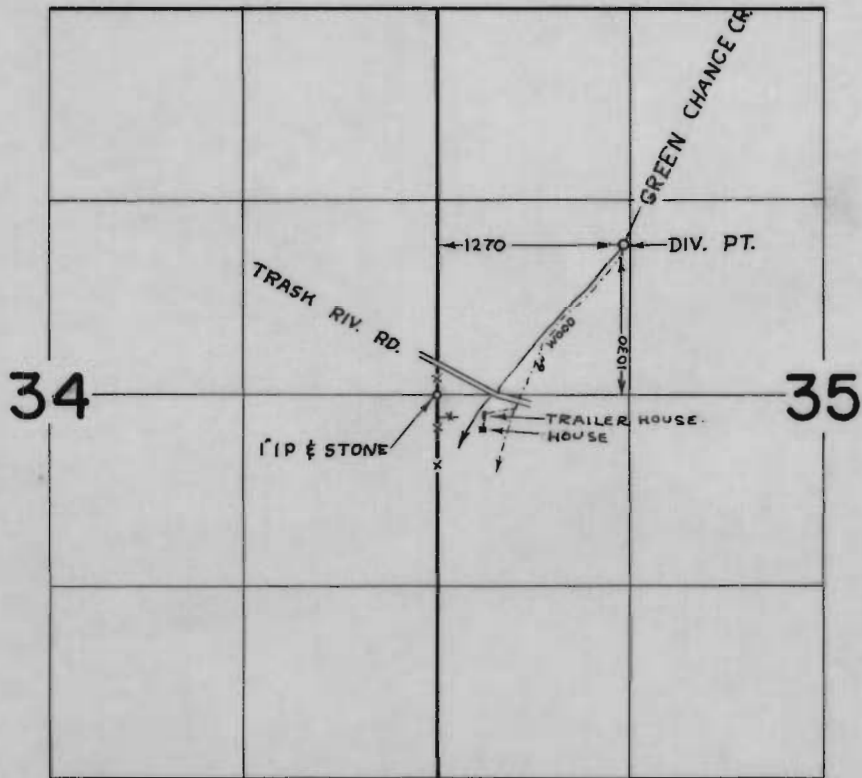

FINAL PROOF SURVEY
UNDER

Application No. 46661 Permit No. 34862
IN NAME OF

LOUIS EDWARD SCOTT

Surveyed AUG 8, 1971, by R. MUCKEN