


T. 5 N. R. 36 E. W. M.

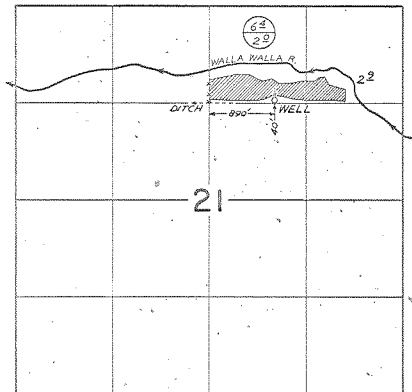


 PRIMARY  
 SUPPLEMENTAL

FINAL PROOF SURVEY  
 UNDER

Application No. G-3005... Permit No. G-2800..  
 IN NAME OF

STEPHEN RICHARD STRICKLAND

Surveyed AUG. 26, 1971., by GREG BACA....