


T. 4 N. R. 29 & 30 E. W. M.

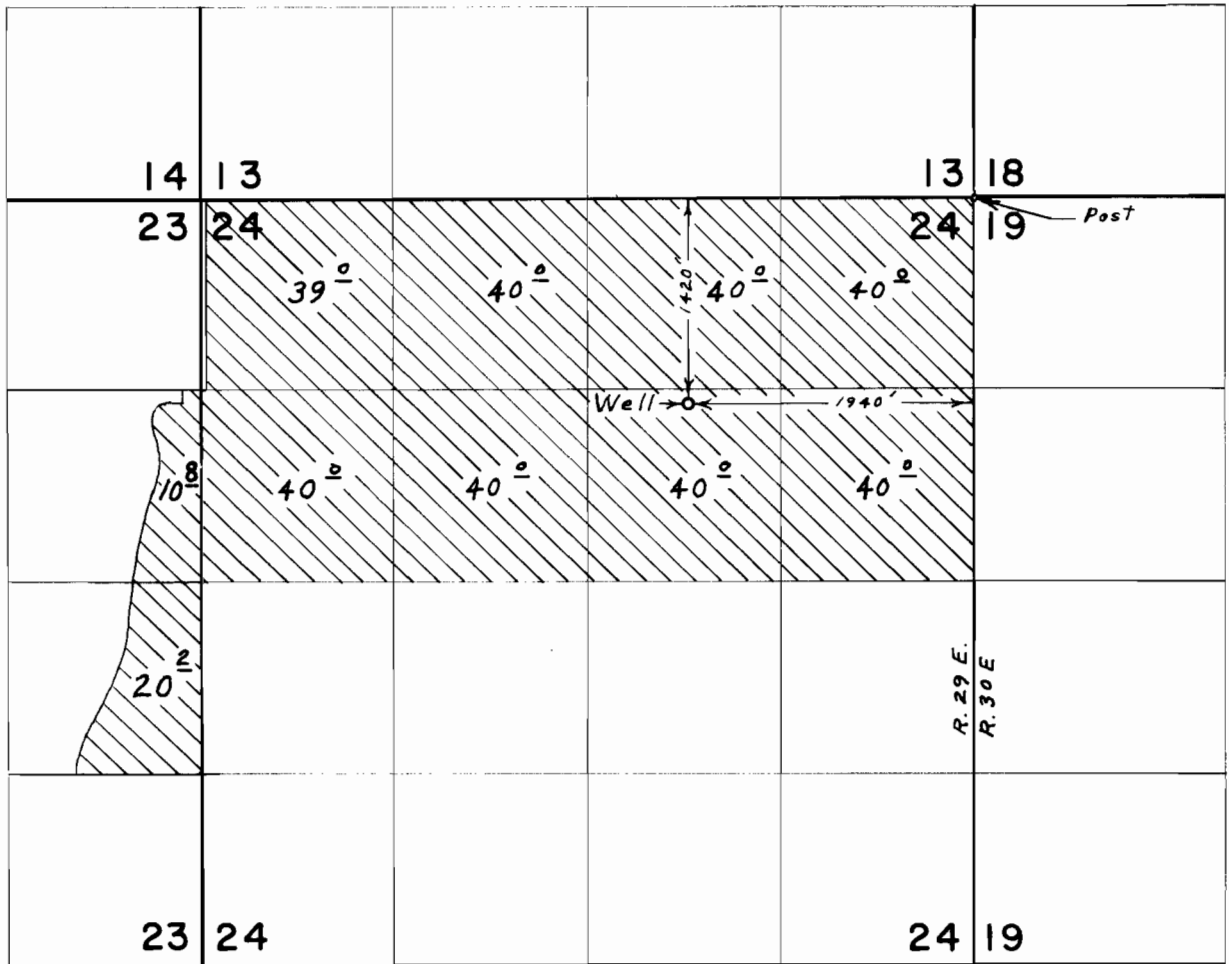

FINAL PROOF SURVEY UNDER

Application No. G-3071 Permit No. G-2874
IN NAME OF

L. E. PEARSON

Surveyed July 1, 1971, by L. E. Gould