


G-3219
38386 7

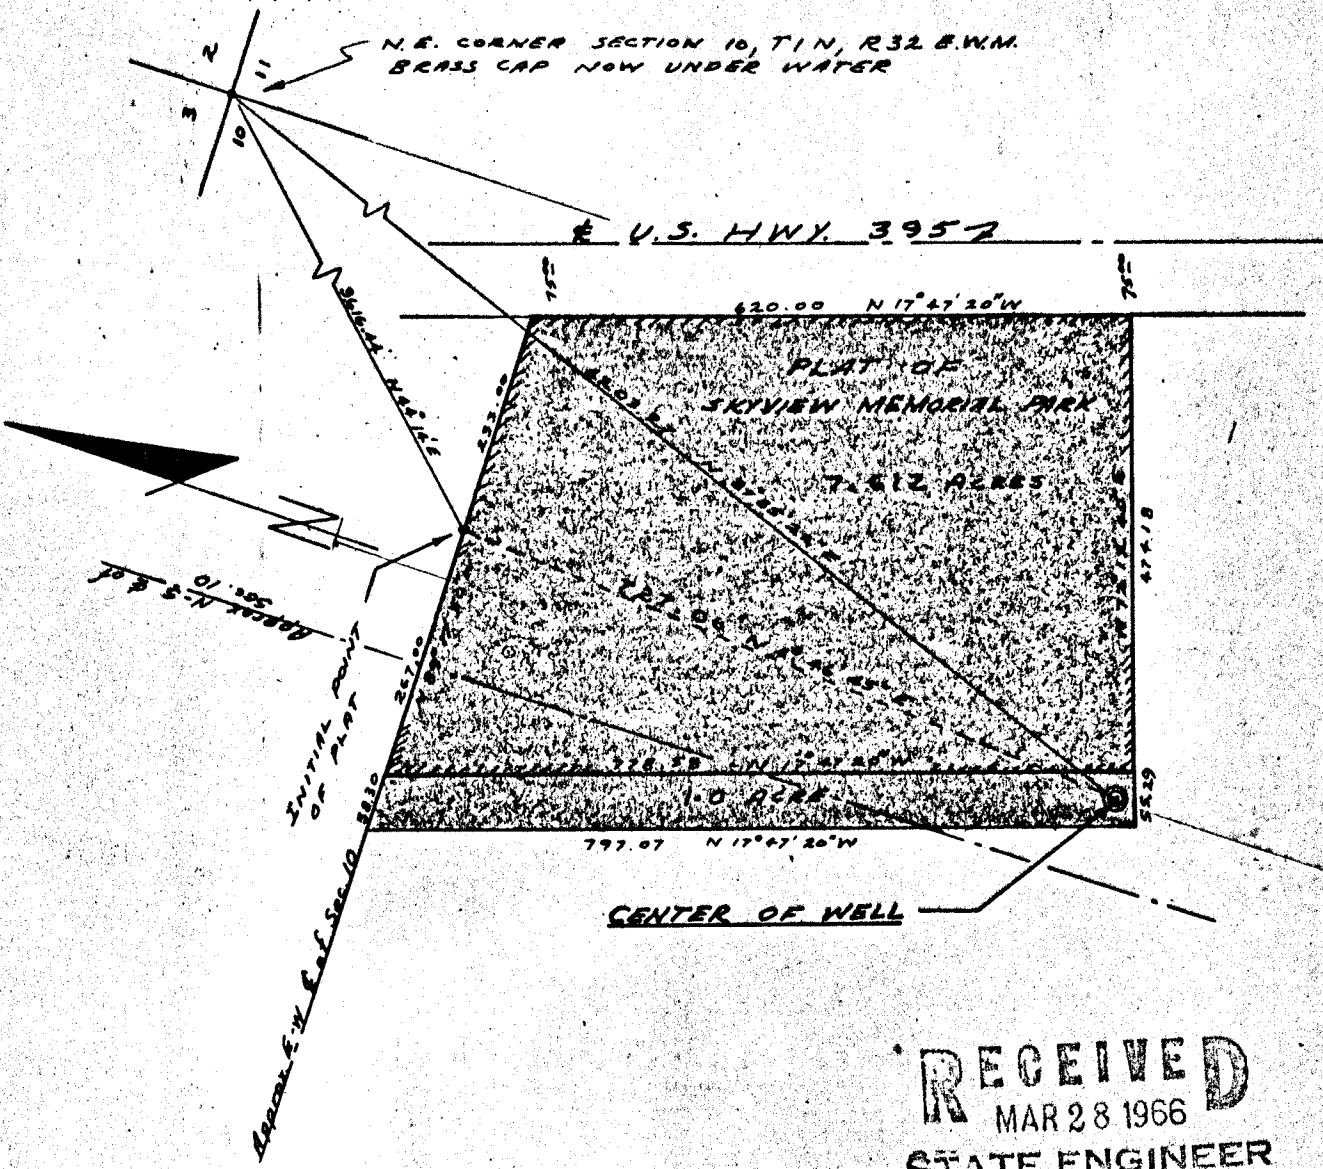

RECEIVED
MAR 28 1966
STATE ENGINEER
SALEM OREGON

RECEIVED
APR 21 1966
STATE ENGINEER
SALEM OREGON

LEGEND

- PLATTED AREA
- AREA TO BE IRRIGATED



Application No. **G-3434**
Permit No. **G-3219**

PROJECT: WATER RIGHT SURVEY		
WATER RIGHT SURVEY FOR SKYVIEW MEMORIAL PARK IRRIGATION WELL		
DR. BY: DLS.	DATE: AUG 23, 1965	SCALE: 1" = 200'
CK. BY:	REV.:	SHEET 1 OF 1
STANLEY G. WALLULIS Consulting Engineer P.O. Box 91 213 S.W. Emigrant Pendleton Oregon		