


G-3412

52573
38387

7

T. 4 N. R. 28 E. W. M.

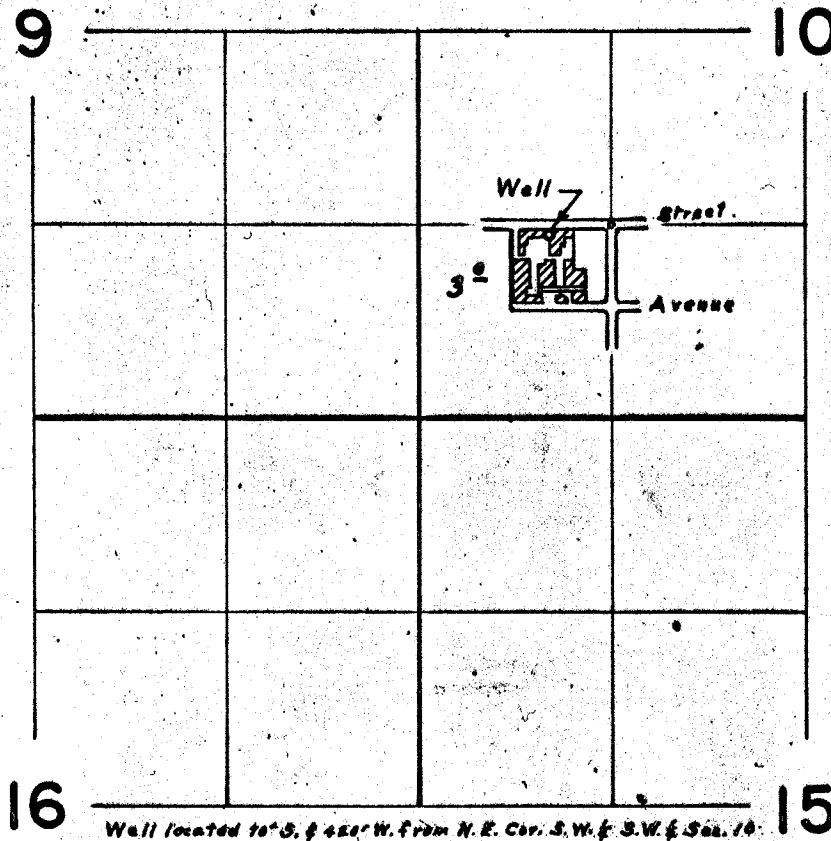

FINAL PROOF SURVEY UNDER

Application No. G-3629 Permit No. G-3412.

IN NAME OF
HERMISTON MEDICAL CENTER
8 VALLE VISTA HOME

Surveyed June 23, 1971, by L. E. Gould.