


## T. 4 N. R. 28 E. W. M.

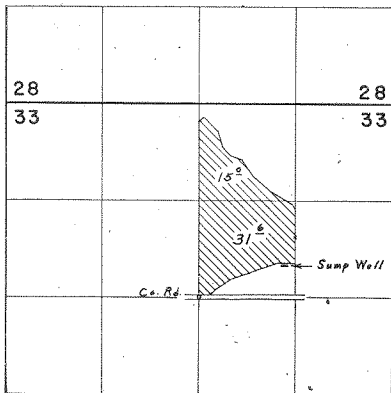

Sump Well located 430' N. & 1170' E. from Center Sec. 33

**FINAL PROOF SURVEY**  
UNDER

Application No. G-3782 Permit No. G-3567  
IN NAME OF

MRS. ROSE MUELLER

Surveyed June 28, 1971, by L. E. Gould.