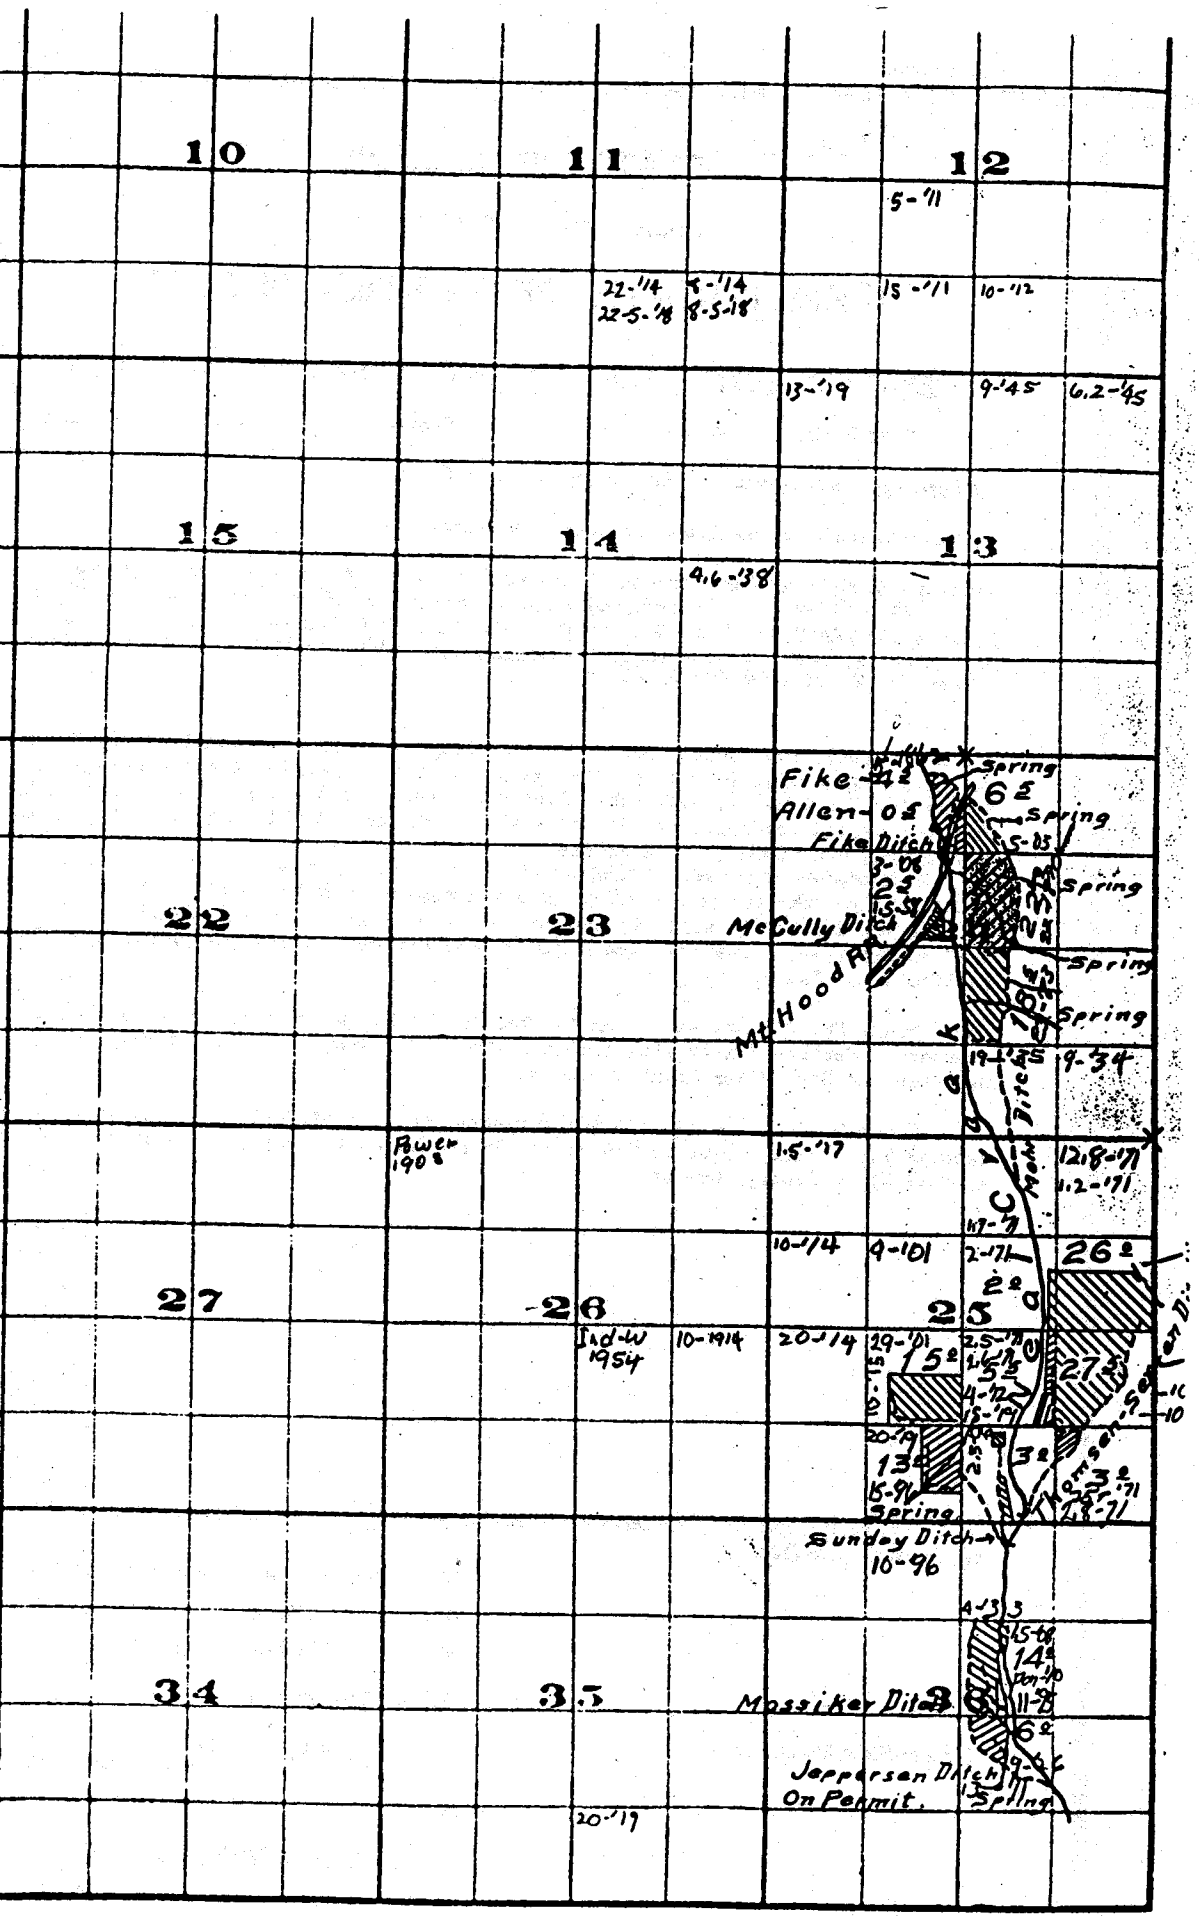

FROM OFFICE OF THE STATE ENGINEER, SALEM, OREGON