


T. 4 N. R. 28 E. W. M. .

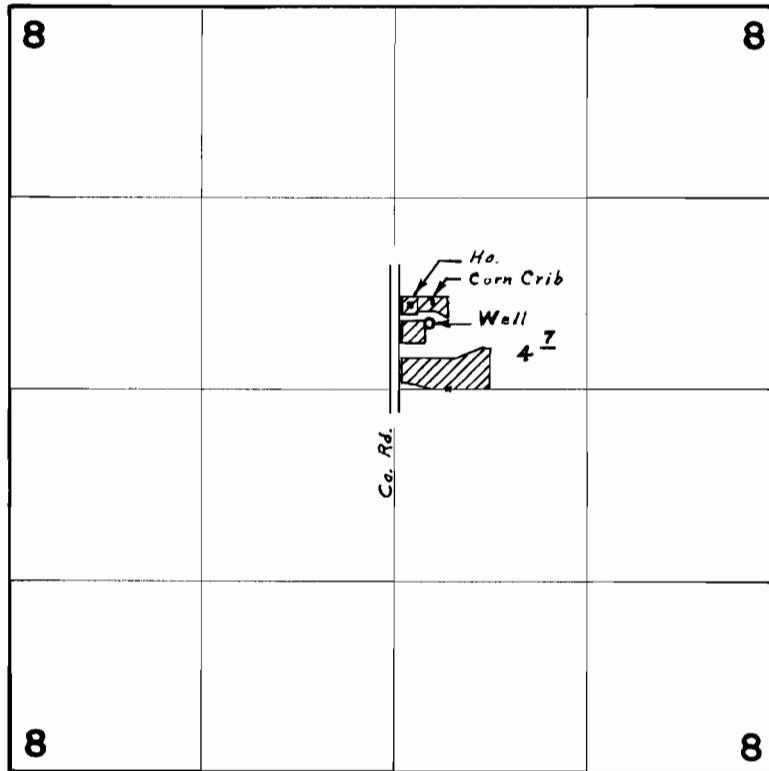

Well located 450' N. & 240' E. From Center Sec. 8

**FINAL PROOF SURVEY**  
UNDER

Application No. G-3991. Permit No. G-3745  
IN NAME OF

DAVID C. RALSTON

Surveyed June 22 1971, by L. E. Gould